

MISSISSIPPI DEPARTMENT OF NATURAL RESOURCES

Bureau of Land and Water Resources

Southport Mall

P.O. Box 10631

Jackson, Mississippi 39209

WATER WELL DRILLERS LOG

Scott  
A 2005  
7-16-85

L

7-16-1985 date well completed F.D. Lonars firm name SCOTT county well located

LANDOWNER: Billy Ewert  
 description of formations encountered  
 from to  
 Chalk 0 60  
 Blue Chalk 60 90  
 Rock 96 100  
 Sand 100 170  
 Gravelly Sand 170 218  
 (mailing address)  
 WELL LOCATION:  
 sec. 14 T 8 S 05 E  
18 miles E of Jackson  
 (distance) (direction) (nearest town)

WELL PURPOSE:  
 (home) irrigation, municipal, industrial

WELL COMPLETION DATA:  
 (1) diameter (inches) 9 1/2  
 (2) total depth (feet) 233'  
 (3) static water level (feet) 180 below top of ground.  
 (4) casing 2" 233'  
 (material) (depth)  
2" if telescope see back.  
 (size)  
 (5) screen 2" 233'  
 (length) (depth to top)  
2" x 20'  
 (size) (material)  
P.V.C.  
 (6) pump 3 220  
 (HP) (yield gpm)  
Elec  
 (type power)  
 (7) electric log NO  
 (yes or no)  
Cap P.V.C.  
 (organization/running log)  
 (8) how well bottom plugged


RECEIVED  
 JUL 23 1985

Department of Natural Resources  
 Bureau of Land & Water Resources

DRILLERS REMARKS:

If well telescopes please sketch and show depths.

GROUND LEVEL

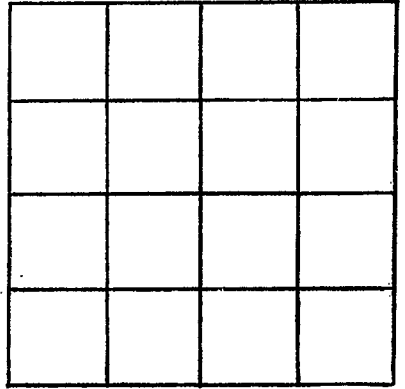

SECTION \_\_\_\_\_

Please indicate well location X.

ADDITIONAL INFORMATION

If more than one screen,  
show locations of each on sketch.