

MISSISSIPPI DEPARTMENT OF NATURAL RESOURCES

Bureau of Land and Water Resources

P.O. Box 10631

Jackson, Mississippi 39209

WATER WELL DRILLERS LOG

COUNTY WELL LOCATED Scott	
WELL NUMBER A	CODED
DATE WELL COMPLETED 2014 1-1-91	

PERMIT NUMBER
NAME OF DRILLING FIRM Gardner Drilling Sebastopol MS

NAME & MAILING ADDRESS OF LANDOWNER Jimmy Latham		
P.O. Box 092 Rt. 2		
Lena, MS 39094		
WELL LOCATION: SEC	TOWNSHIP	RANGE
21	8 N	6 E
DISTANCE	DIRECTION	NEAREST TOWN
10 Miles	N	of Morton
OTHER LANDMARK		
WELL PURPOSE: Home, Irrigation, Municipal, Industrial, Fish Pond, etc. Poultry Farm		

PUMP DATA		
PUMP TYPE (Circle One): Submersible , Turbine, Jet, Flowing Well, Other (Describe)		
POWER TYPE (Circle One): Electric , Tractor, Diesel, Gasoline, Butane, Other (Describe) H/P		
Pump Capacity (GPM) 18	No. of Stages 12	Setting Depth 60 FT.
PUMP TEST		
Well yielded 60 GPM with a drawdown of 12 ft. after 2 hours of pumping		


WELL DATA		
Well Depth 277	Casing Diameter (In.) 4	Casing Length (Ft.) 277
Type of Casing PVC	Hole Depth 277	Depth to Static Water Level 45
TYPE OF COMPLETION: (Circle One or More): Gravel Packed, Underreamed, Telescoped , Natural Development, Open Hole, Other (Describe)		
Top of Lap Pipe or Reduction in Casing FEET <input type="checkbox"/> IF TELESCOPED OR MORE THAN ONE SCREEN: USE BACK PAGE		

LOG DATA	
TYPE OF LOG RUN (Circle One): No Log Run, Electric, Gamma Ray, Density, Sonic, Neutron, Other (Describe)	
Name of Organization Running Log	

SCREEN DATA		
Diameter - Inches 2"	Length - Feet 20	Slot Size - Inches 8
Screen Type PVC		Depth to Bottom - Feet 277


GEOLOGIC DATA (Office Use Only)			
Surface Elev.	Geologic Unit	Unit Thickness	Depth to Top
Subs. SWL	Date	Analysis	Aquifer Test
Driller's Remarks			

DESCRIPTION OF FORMATIONS ENCOUNTERED	FROM	TO
Clay + Sand Muck	0	20
Clay + Sand Ledge	20	60
Shell ledges	60	67
Clay + Sand Ledges	67	180

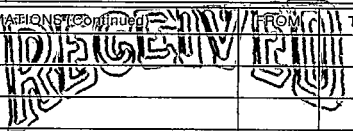FORMATIONS (Continued) FROM TO	
	
FEB 15 1991	
Dept. of Environmental Quality Bureau of Land & Water Resources	
IF MORE SPACE IS NEEDED, USE BACK	

If well telescopes please sketch and show depths.

GROUND LEVEL

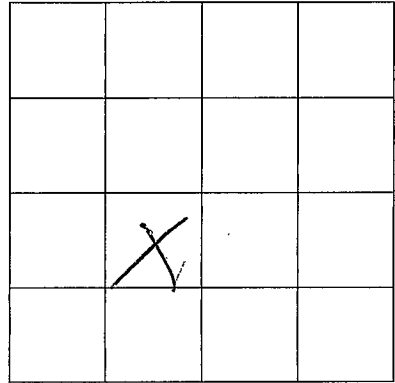

SECTION 21

Please indicate well location X.

ADDITIONAL INFORMATION

If more than one screen, show location of each on sketch.