

MISSISSIPPI DEPARTMENT OF ENVIRONMENTAL QUALITY

Office of Land and Water Resources

P. O. Box 10631
Jackson, MS 39289-0631
WATER WELL DRILLERS LOG

COUNTY WELL LOCATED <u>SCOTT</u>	
WELL NUMBER <u>#3</u>	CODED
DATE WELL COMPLETED <u>6-25-99</u>	

PERMIT NUMBER
NAME OF DRILLING FIRM <u>GARDNER DRILLING</u>
<u>SEBASTOPOL, MS. 39359</u>

NAME & MAILING ADDRESS OF LANDOWNER <u>JIMMY LEWIS</u>			
<u>1301 INDEPENDENCE RD.</u>			
<u>MORTON, MS. 39117</u>			
WELL LOCATION	SEC	TOWNSHIP	RANGE
	<u>32</u>	<u>8</u>	<u>N 6 E</u>
DISTANCE	DIRECTION	NEAREST TOWN	
<u>12</u> Miles	<u>N</u>	of <u>MORTON</u>	
OTHER LANDMARK			
WELL PURPOSE Home, Irrigation, Municipal, Industrial, Fish Pond, etc. <u>POULTRY FARM</u>			

PUMP DATA		
PUMP TYPE (Circle One): <u>Submersible</u> Turbine, Jet, Flowing Well, Other (Describe)		
POWER TYPE (Circle One): <u>Electric</u> Tractor, Diesel, Gasoline, Butane, Other (Describe) H/P <u>1</u>		
Pump Capacity (GPM) <u>20</u>	No of Stages <u>10</u>	Setting Depth <u>100</u> FT.
PUMP TEST		
Well yielded <u>30</u> GPM with a drawdown of <u>5</u> ft. after <u>8</u> hours of pumping		

WELL DATA		
Well Depth <u>280'</u>	Casing Diameter (In) <u>4" X 2"</u>	Casing Length (Ft) <u>20</u>
Type of Casing <u>PVC</u>	Hole Depth <u>280'</u>	Depth to Static Water Level <u>45'</u>
TYPE OF COMPLETION: (Circle One or More): Gravel Packed, Underreamed, <u>Telescoped</u> , Natural Development, Open Hole, Other (Describe)		
WELL GROUTED TO A DEPTH OF _____ FEET Type Grout (circle one): Cement, Bentonite, or Mix		

LOG DATA	
TYPE OF LOG RUN (Circle One): No Log Run, Electric, Gamma Ray, Density, Sonic, Neutron, Other (Describe)	
Name of Organization Running Log	

SCREEN DATA		
Diameter - Inches <u>2"</u>	Length - Feet <u>20'</u>	Slot Size - Inches <u>8</u>
Screen Type <u>PVC Rib</u>	Depth to Bottom - Feet <u>280'</u>	


GEOLOGIC DATA (Office Use Only)			
Surface Elev	Geologic Unit	Unit Thickness	Depth to Top
Subs SWL	Date	Analysis	Aquifer Test
Driller's Remarks RECEIVED			
Top of Lap Pipe or Reduction in Casing <u>FEET</u> <u>1-2-2000</u> IF TELESCOPED OR MORE THAN ONE SCREEN: USE BACK PAGE			

DESCRIPTION OF FORMATIONS ENCOUNTERED	FROM	TO	FORMATIONS (Continued)	FROM	TO
<u>Yellow Clay</u>	<u>0</u>	<u>20</u>	<u>Dept. of Environmental Quality</u>		
<u>Rock</u>	<u>20</u>	<u>21</u>	<u>Office of Land & Water Resources</u>		
<u>Clay</u>	<u>21</u>	<u>220</u>			
<u>Sand</u>	<u>220</u>	<u>280</u>			

IF MORE SPACE IS NEEDED, USE BACK

If well telescopes please sketch and show depths.

GROUND LEVEL

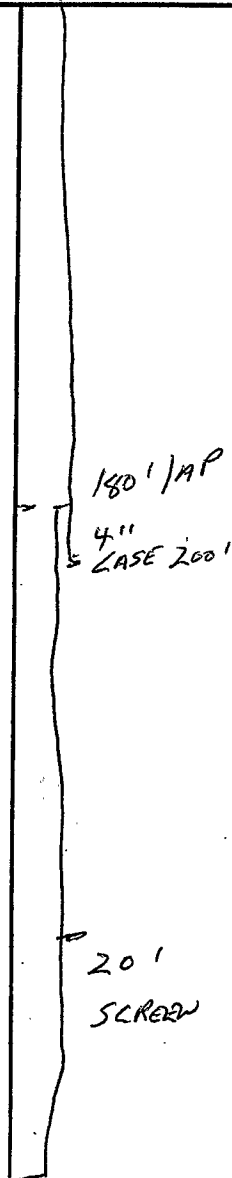

	X		

SECTION 32

Please indicate well location X.

ADDITIONAL INFORMATION

Multiple horizontal lines for additional information.

If more than one screen,