

3 B1 T
6-7-63

WATER WELL DRILLERS LOG

2

Date: June 7, 1963, Driller: Nearon Drilling County Scott
(Name)

(1) Owner of Land: W.B. Meador
(Name)
Box 204 R.1 Lena, Miss
(Address)
(2) Location: SE 1/4 NE 1/4, Sec. 3 T8R7E
3 1/2 miles SE of Lena
(distance) (direction) (Nearest Town)
(3) Topography: Hilly
(Flat) (Level)
(4) Purpose of Well: Domestic
(Domestic Irrigation Municipal, Industrial, Other)


Description & Color of Materials Sand, Clay, Red Clay, Shell, etc.	Thick-ness Feet	Dept Feet
Clay	10	10
Strawberry Sand	60	70
Strawberry Sand & Soapstone	30	100
Soapstone & Sand	20	120
White Sand	30	150
Soft Soapstone	10	160
Sand and Soapstone	16	170
Yellow Sand	10	180

Information upon completion of well:

(1) Diameter 2 inches.
(2) Total Depth 150 feet.
(3) Water Level 61 1/2 feet below top of ground.
(4) Cased to 145', Size 2"
(5) Screen: Size 2 1/2" by , Length 5'
(6) Were any formations sealed against pollution?
_____ yes, no.

If YES depth of formation _____
Why _____

Drillers Remarks: air compressor
well out put - gallons
per hour, soft water

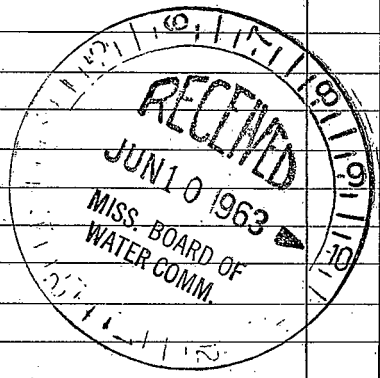

(Use Back Side)

Well No.

