

4 B 2
7-3-64

T
WATER WELL DRILLERS LOG

3

Date: 7/3, 1964, Driller: Frost Drilling County Scott
(Name)


(1) Owner of Land:	Description & Color of Materials Sand, Clay, Red Clay, Shell, etc.	Thick- ness Feet	Depth Feet
(Name) <u>Jim Tyler</u> (Address) <u>Rt 3 Frost, Miss</u>	<u>Brown Clay</u>		<u>22</u>
(2) Location: <u>1/4</u> , <u>1/4</u> , Sec. <u>26</u> T. <u>R</u>	<u>Clay + Sh. Fine Sand</u>		<u>48</u>
<u>3 1/2</u> miles <u>NW</u> , of <u>Hillboro</u>	<u>Clay</u>		<u>72</u>
(3) Topography: <u>X</u> (Hilly) <u>(Flat)</u> (Level)	<u>Clay + Fine Sand</u>		<u>82</u>
(4) Purpose of Well: <u>Home</u> (Domestic Irrigation, Municipal, Industrial, Other)	<u>Fine Sand</u>		<u>119</u>
	<u>Clay</u>		<u>132</u>
	<u>Sand + Sh. Clay</u>		<u>152</u>

Information upon completion of well:

- (1) Diameter 2 inches.
- (2) Total Depth 145 feet.
- (3) Water Level 60 feet below top of ground.
- (4) Cased to 140, Size 2"
- (5) Screen: Size 2 1/2" Length 5 ft
- (6) Were any formations sealed against pollution?
no

If YES depth of formation _____
Why _____

Drillers Remarks: _____

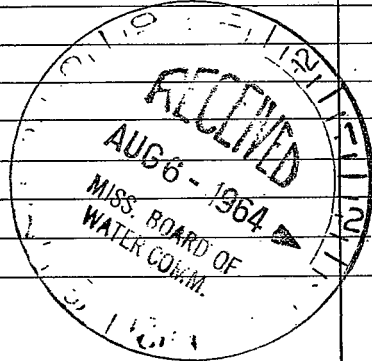

(Use Back Side)

Well No.

