

6 B 3
11-16-64

WATER WELL DRILLERS LOG

Date: 11/16, 1964, Driller: Forest Drilling Ser. Scott
County Scott
(Name)

(1) Owner of Land: E. L. Coward
(Name)
Rt 3 Lena, Miss.
(Address)

(2) Location: 1/4, 1/4, Sec. 29 ^{RN 1E} T R
7 miles South of Lena
(distance) (direction) (Nearest Town)

(3) Topography: Flat
(Hilly) (Flat) (Level)

(4) Purpose of Well: None
(Domestic Irrigation
Municipal, Industrial, Other)

Description & Color of Materials Sand, Clay, Red Clay, Shell, etc.	Thick- ness Feet	Depth Feet
<u>Brown Clay</u>	<u>0</u>	<u>24</u>
<u>Blue Clay + Fine Sand</u>		<u>37</u>
<u>Clay + Shell</u>		<u>52</u>
<u>Clay + 1/2" fine sand</u>		<u>102</u>
<u>fine sand + 1/2" clay</u>		<u>122</u>
<u>fine sand</u>		<u>142</u>
<u>fine sand</u>		<u>202</u>
<u>fine sand + 1/2" clay</u>		<u>212</u>
<u>fine sand</u>		<u>217</u>
<u>Clay</u>		<u>222</u>
<u>fine sand + 1/2" clay</u>		<u>252</u>
<u>fine sand</u>		

Information upon completion of well:

(1) Diameter 2 inches.

(2) Total Depth 325 feet.

(3) Water Level 90 ft feet below top of ground.

(4) Cased to 315, Size 2"

(5) Screen: Size 2", Length 10 ft


(6) Were any formations sealed against pollution?
 _____ yes, X no.

If YES depth of formation _____

Why _____

Drillers Remarks: _____

Please send me some

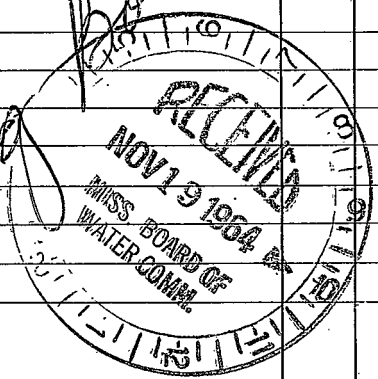

(Use Back Side)

Well No.

[The page contains extremely faint and illegible text, likely bleed-through from the reverse side of the document. No specific words or phrases can be discerned.]