

SCOTT MISSISSIPPI BOARD OF WATER COMMISSIONERS

B4
1-21-65

WATER WELL DRILLERS LOG

4


Date: 1/21, 1965, Driller: Scott Drilling Co. County: Scott
(Name)

| | Description & Color of Materials Sand, Clay, Red Clay, Shell, etc. | Thick- ness Feet | Depth Feet |
|--|---|------------------------|---------------|
| (1) Owner of Land: <u>Edward Milnes</u> (Name) <u>Leona Miss</u> (Address) | <u>Red Clay</u> | | <u>12</u> |
| (2) Location: <u>1/4</u> , <u>1/4</u> , Sec. <u>21</u> T. <u>8</u> R. <u>12</u> <u>.5</u> miles <u>West</u> of <u>Harpersville</u> (distance) (direction) (Nearest Town) | <u>Clay + 1/2 ch. blue sand</u> | | <u>22</u> |
| (3) Topography: <u>✓</u> (Hilly) (Flat) (Level) | <u>Clay</u> | | <u>62</u> |
| (4) Purpose of Well: <u>Chickens</u> (Domestic Irrigation Municipal, Industrial, Other) | <u>Clay + 1/2 ch. sand</u> | | <u>72</u> |
| | <u>Clay</u> | | <u>102</u> |
| | <u>Clay + 1/2 ch. fine sand</u> | | <u>112</u> |
| | <u>fine sand + 1/2 ch. clay</u> | | <u>147</u> |
| | <u>Clay + 1/2 ch. fine sand</u> | | <u>172</u> |
| | <u>blue sand</u> | | <u>185</u> |

Information upon completion of well:

- (1) Diameter 2" inches.
- (2) Total Depth 152 feet.
- (3) Water Level 43 feet below top of ground.
- (4) Cased to 147, Size 2"
- (5) Screen: Size 2 1/2", Length 5 ft.
- (6) Were any formations sealed against pollution?
 yes, no.

If YES depth of formation _____
 Why _____
 Drillers Remarks: _____

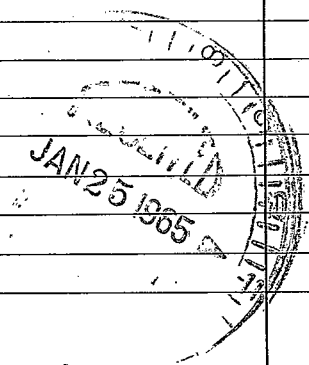

(Use Back Side)

Well No.

