

MISSISSIPPI BOARD OF WATER COMMISSIONERS

SCOTT

5 B6
12-2-60

7 WATER WELL DRILLERS LOG

Scott?

Date: 12-2, 1960, Driller: J P Thornton County Leflore

(Name)

(1) Owner of Land: Miller
(Name)

(Address)

(2) Location: 1/4, 1/4, Sec. 11 T8R7
4 miles South of Lena
(distance) (direction) (Nearest Town)

(3) Topography: flat
(Hilly) (Flat) (Level)

(4) Purpose of Well: Domestic
(Domestic Irrigation
Municipal, Industrial, Other)

Description & Color of Materials Sand, Clay, Red Clay, Shell, etc.	Thick-ness Feet	Depth Feet
Red Clay	47	
yellow sand & white clay	14	
Gray sand	8	

Information upon completion of well:

(1) Diameter 2 inches.

(2) Total Depth 90 feet.

(3) Water Level 55' feet below top of ground.

(4) Cased to 84', Size 2"


(5) Screen: Size 1 1/4" galv, Length 6 ft

(6) Were any formations sealed against pollution?
 yes, no.

If YES depth of formation _____

Why _____

Drillers Remarks: 390 gal per hour

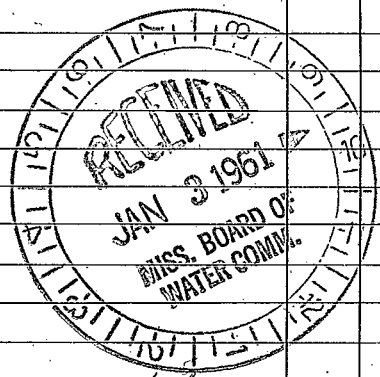

61390
3690
(Use Back Side)

Well No.

Retain this copy for your office files.

