

B7  
11-28-61

T  
WATER WELL DRILLERS LOG

B

Date: 11-28, 19 61, Driller: J P Thornton County Scott Lake  
(Name)


- (1) Owner of Land: Orhel Lyle  
(Name)  
Lena miss  
(Address)
- (2) Location:  $\frac{1}{4}$ ,  $\frac{1}{4}$ , Sec. 10 T & R 7,  
4 miles South, of Lena  
(distance) (direction) (Nearest Town)
- (3) Topography: \_\_\_\_\_  
(Hilly) (Flat) (Level)
- (4) Purpose of Well: Domestic  
(Domestic Irrigation  
Municipal, Industrial, Other)

Description & Color of Materials Sand, Clay, Red Clay, Shell, etc.	Thick- ness Feet	Depth Feet
<u>red clay</u>	<u>12</u>	
<u>white chalk</u>	<u>30</u>	
<u>fine yellow sand</u>	<u>10</u>	
<u>pink chalk</u>	<u>5</u>	
<u>med sand</u>	<u>10</u>	
<u>pink chalk</u>	<u>2</u>	
<u>real coarse white sand</u>	<u>15</u>	

Information upon completion of well:

- (1) Diameter 2 inches.
- (2) Total Depth 84 feet.
- (3) Water Level 40 feet below top of ground.
- (4) Cased to 79', Size 2"
- (5) Screen: Size 1 1/4, Length 6 ft.
- (6) Were any formations sealed against pollution?  
\_\_\_\_\_ yes, \_\_\_\_\_  no.

If YES depth of formation \_\_\_\_\_  
Why \_\_\_\_\_  
Drillers Remarks: 450 gal per hr.

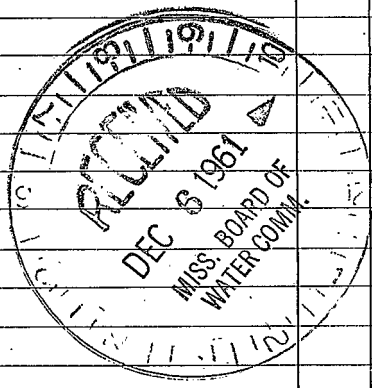

(Use Back Side)

Well No.

