

SCOTT

B

4-28-62

WATER WELL DRILLERS LOG

FOREST DRILLING SERVICE

Date: 4/28, 1962, Driller: 231 Highway 35 North County Scott
FOREST, MISSISSIPPI
Name

(1) Owner of Land:	Description & Color of Materials Sand, Clay, Red Clay, Shell, etc.	Thick- ness Feet	Depth Feet
Billy R. Gunn (Name) Lena Gunn (Address)	0-10 Red Clay Red Sand	10	10
(2) Location: 1/4, 1/4, Sec. 16 T R	5th Sand & Clay	97	107
7 miles NW, of Helleboro (distance) (direction) (Nearest Town)	Clay Soft Blue Clay Fine Sand	52	159
(3) Topography: X (Hilly) (Flat) (Level)		24	183
(4) Purpose of Well: Home (Domestic Irrigation Municipal, Industrial, Other)		14	197


Information upon completion of well:

- (1) Diameter 2 inches.
- (2) Total Depth 197 feet.
- (3) Water Level 57 feet below top of ground.
- (4) Cased to 187, Size 2"
- (5) Screen: Size 2", Length 10'
- (6) Were any formations sealed against pollution?
yes, X no.

If YES depth of formation _____

Why _____

Drillers Remarks: _____

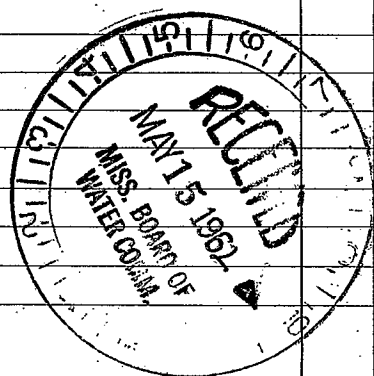

(Use Back Side)

Well No.

