

MISSISSIPPI BOARD OF WATER COMMISSIONERS

SCOTT  
B 9 WATER WELL DRILLERS LOG

3 2-18-63

Date: 2-18, 1963, Driller: Ray Cox County: SCOTT  
(Name)

(1) Owner of Land: Cash Baptist Church  
(Name)  
7 Line  
(Address)

(2) Location: SW 1/4, SE 1/4, Sec 24 T.8 R.7  
3  
8 miles N.70 of Hillsboro  
(distance) (direction) (Nearest Town)

(3) Topography: X  
(Hilly) (Flat) (Level)

(4) Purpose of Well: Domestic  
(Domestic Irrigation  
Municipal, Industrial, Other)

Description & Color of Materials Sand, Clay, Red Clay, Shell, etc.	Thick- ness Feet	Depth Feet
0 to 20' R Clay		
20 to 40 Yellow sand & Chalk		
40 to 65 White Sand & Chalk		
65 to 85 Sand, white		
85 to 110' White Chalk & Sand		
110 to 131' White Sand		

Information upon completion of well:

(1) Diameter 2" inches.

(2) Total Depth 131 feet.


(3) Water Level 48 to 50 feet below top of ground.

(4) Cased to 126, Size 2"

(5) Screen: Size 2", Length 5 feet.

(6) Were any formations sealed against pollution?  
\_\_\_\_\_ yes, \_\_\_\_\_ no.

If YES depth of formation \_\_\_\_\_  
Why \_\_\_\_\_  
Drillers Remarks: \_\_\_\_\_

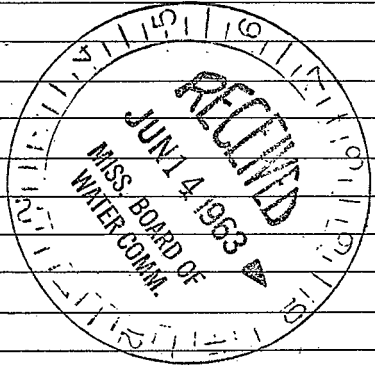

Comment Well Drilling  
School Miss

(Use Back Side)

Well No.

100

101

102

200