

**MISSISSIPPI  
BOARD OF WATER COMMISSIONERS**  
416 North State Street  
Jackson, Mississippi 39201

**WATER WELL DRILLERS LOG**

SCOTT
B 10
4-68

4-19 1968 Forest Drilling Scott  
 date well completed firm name county well located

LANDOWNER: <u>Murphy Roberts</u>	description of formations encountered	from	to
		15	56
LANDING ADDRESS: <u>Lena Bias</u> (mailing address)	Clay	61	81
	Sand	81	87
	7 Sand + Clay	87	102
	7 Sand + 5th Clay	102	122
	Sand	122	163
	Sand + Clay	163	183
	Clay + 5th Sand	183	204
	Clay + 5th Sand	204	220
	Clay + 5th Sand	220	240
	Good Sand	240	

WELL LOCATION:  
 sec. 12 T. 2 N. R. 7 E  
7 miles (distance) N (direction) Hillsboro (nearest town)

WELL PURPOSE: Home  
 (home, irrigation, municipal, industrial)

WELL COMPLETION DATA:  
 (1) diameter (inches) 2"  
 (2) total depth (feet) 240  
 (3) static water level (feet) 94 below top of ground

(4) casing Galv. (material) 235 (depth)  
2" (size) if telescope see back.

(5) screen 5ft (length) 235 (depth to top)  
2" (size) Stainless Steel (material)

(6) pump 2 (HP) 450 P.H. (yield gpm)  
Jet Elect (type power)

(7) electric log no (yes or no)

(organization running log)


(8) how well bottom plugged Good

DRILLERS REMARKS:

MAY 16 1968  
 MISS. BD. OF WATER COMMISSIONERS

If well telescopes please sketch and show depths.

GROUND LEVEL

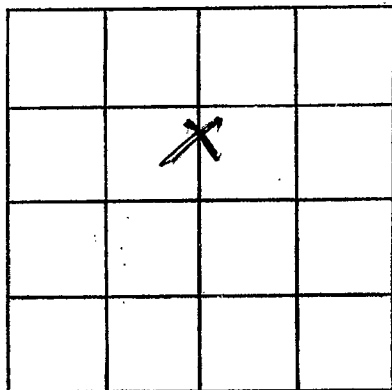

SECTION 12

Please indicate well location X.

ADDITIONAL INFORMATION

If more than one screen, show locations of each on sketch.