

SCOTT  
 AB12  
 8-29-60

WATER WELL DRILLERS LOG

A 300

CODED

Date: 8-29, 1960, Driller: J.P. Thornton County: Scott

(Name)

(1) Owner of Land: C.L. Lyle

(Name)

Sena miss

(Address)

(2) Location: 1/4, 1/4, Sec. 3 8 N 7 E

N Sloy Hill

4 miles ~~west~~, of ~~Bas~~

(distance)

(direction)

(Nearest Town)

(3) Topography: hills

(Hilly)

(Flat)

(Level)

(4) Purpose of Well: Domestic

(Domestic Irrigation  
 Municipal, Industrial, Other)

Description & Color of Materials  
 Sand, Clay, Red Clay, Shell, etc.

Thick-  
 ness  
 Feet

Depth  
 Feet

Yellow clay + sand  
 Real fine Black sand  
 fine gray sand  
 Coarse Gray sand

40  
 60  
 20  
 36

CODED

Information upon completion of well:

- (1) Diameter 2 inches.
- (2) Total Depth 15'6 feet.
- (3) Water Level 40 feet below top of ground.
- (4) Cased to 147, Size 2"
- (5) Screen: Size 14 8/16 gauge Length 6 ft
- (6) Were any formations sealed against pollution?


yes, X no.

If YES depth of formation \_\_\_\_\_

Why \_\_\_\_\_

Drillers Remarks: 6000 gallon per hour

60  
 00  
 15  
 60  
 50  
 30  
 60  
 15  
 00  
 60  
 15  
 00

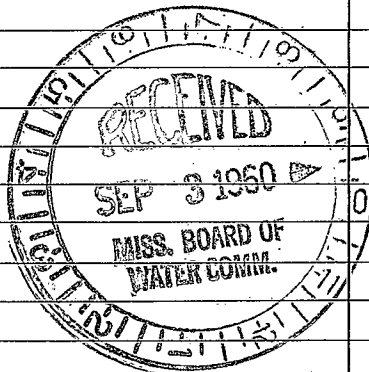

(Use Back Side)

Well No.

SISS