

WATER WELL DRILLERS LOG

CODED

SCOTT
B15
2/15/63

Date: 2-15, 1963, Driller: LEACH County SCOTT
(Name)

(1) Owner of Land: J. S. Pope
(Name)
Morton M. 55
(Address)

(2) Location: 1-8-7
3 miles north of CLIXTON
(distance) (direction) (Nearest Town)

(3) Topography: (Hilly) (Flat) (Level)

(4) Purpose of Well: Domestic
(Domestic Irrigation
Municipal, Industrial, Other)

Description & Color of Materials Sand, Clay, Red, Clay, Shell, etc.	Thick- ness Feet	Depth Feet
<u>Clay</u>	<u>50</u>	<u>50</u>
<u>sand</u>	<u>15</u>	<u>65</u>
<u>Sand & clay</u>	<u>10</u>	<u>75</u>
<u>Sand</u>	<u>18</u>	<u>93</u>


Information upon completion of well:

- (1) Diameter 2 inches.
- (2) Total Depth 153 feet.
- (3) Water Level 50 feet below top of ground.
- (4) Cased to 153, Size _____.
- (5) Screen: Size 2", Length 6".
- (6) Were any formations sealed against pollution?
 yes, no.

If YES depth of formation 60 ft.
Why 7 in sand

Drillers Remarks: _____

CODED

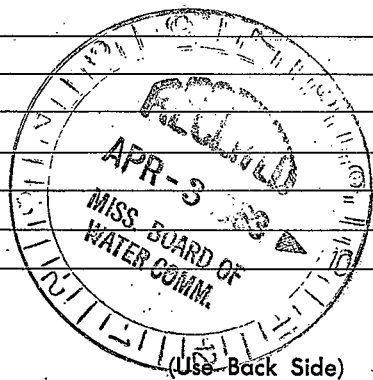

(Use Back Side)

Well No.

