

SCOTT
B 16
7-19-71

MISSISSIPPI
BOARD OF WATER COMMISSIONERS
416 North State Street
Jackson, Mississippi 39201

CODED

WATER WELL DRILLERS LOG

7-19
date well completed

19 71 Forest Drilling Ser.
firm name

Scott
county well located

LANDOWNER: <u>Joe Holifield</u>	description of formations encountered	from	to
<u>Route 3, Forest, Miss.</u>			
(mailing address)	Red Clay	0	10
	Sand + clay	10	40
	Clay	40	61
	Clay & lts fine sand	61	91
	fine sand	91	132
WELL LOCATION:			
sec. <u>22</u> T. <u>8</u> N. R. <u>7</u> E			
<u>7</u> miles <u>NE</u> of <u>Helena</u>			
(distance) (direction) (nearest town)			
WELL PURPOSE: <u>Home</u>			
(home, irrigation, municipal, industrial)			
WELL COMPLETION DATA:			
(1) diameter (inches) <u>2"</u>			
(2) total depth (feet) <u>132 ft</u>			
(3) static water level (feet) <u>47'</u> below top of ground.			
(4) casing <u>galv.</u> <u>126'</u>			
(material) (depth)			
<u>2"</u> if telescope see back.			
(size)			
(5) screen <u>6'</u> <u>126'</u>			
(length) (depth to top)			
<u>2"</u> <u>stainless steel</u>			
(size) (material)			
(6) pump <u>By Customer</u>			
(HP) (yield gpm)			
(type power)			
(7) electric log <u>no</u>			
(yes or no)			
(organization running log)			
(8) how well bottom plugged <u>2"</u>			
<u>Backwash Valve</u>			
DRILLERS REMARKS:			


CODED

JUL 22 1971

MISS. BD. OF
WATER COMM.

If well telescopes please sketch and show depths.

GROUND LEVEL

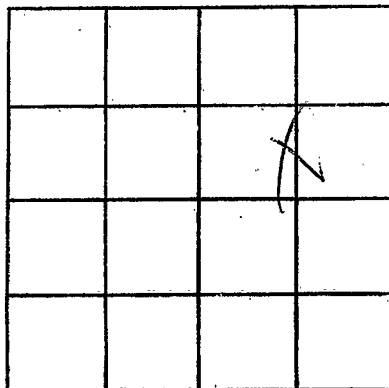

SECTION 22

Please indicate well location X.

ADDITIONAL INFORMATION

If more than one screen,
show locations of each on sketch.