

SCOTT
B17
4-6-72

CODED

MISSISSIPPI
BOARD OF WATER COMMISSIONERS
416 North State Street
Jackson, Mississippi 39201

CODED

WATER WELL DRILLERS LOG

4-6-72
date well completed

Common Drilling Service, Inc.
firm name

county well located

LANDOWNER: W.C. Lyles
LeNA R#3 Area

(mailing address)

WELL LOCATION:
sec. 10 T. 8 N. R. 7 E.
5 miles West of Hillsboro
(distance) (direction) (nearest town)

description of formations encountered	from	to
Clay	0	60
Sandy Clay	60	140
Blue Clay	140	250
Sandy Clay	250	230
Sand	230	250

WELL PURPOSE: Home
(home, irrigation, municipal, industrial)

WELL COMPLETION DATA:

- (1) diameter (inches) 2 1/2
- (2) total depth (feet) 250
- (3) static water level (feet) 80 below above top of ground.
- (4) casing Steel, 240
(material) (depth)
(size) if telescope see back.
- (5) screen 10, 240
(length) (depth to top)
3/4", 45
(size) (material)
- (6) pump 1 1/2, 10
(HP) (yield gpm)
Electric
(type power)
- (7) electric log Yes
(yes or no)

CODED

APR 14 1972

MISS. BD. OF
WATER COM.


(organization running log)

(8) how well bottom plugged

DRILLERS REMARKS:

If well telescopes please sketch and show depths.

GROUND LEVEL

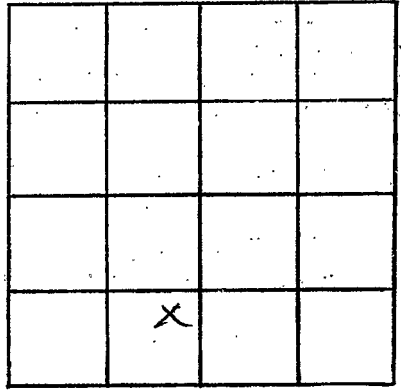

SECTION 10

Please indicate well location X.

ADDITIONAL INFORMATION

If more than one screen, show locations of each on sketch.