

SCOTT
B19
10-31-72

MISSISSIPPI
BOARD OF WATER COMMISSIONERS
416 North State Street
Jackson, Mississippi 39201

WATER WELL DRILLERS LOG

CODED

Oct 31 1972 Wilkerson Drill Serv Scott
date well completed firm name county well located

LANDOWNER: Charlie Shepherd
Lena, Mrs
Route
(mailing address)

description of formations encountered	from	to
Yellow Clay	0	25
Dark Alsch	25	95
fine sand	95	105
Coarse Water Sand	105	130

WELL LOCATION:
sec 8 T 8 N R 7 E
2 miles S.E. of Lena
(distance) (direction) (nearest town)

WELL PURPOSE:
(home, irrigation, municipal, industrial)

- WELL COMPLETION DATA:
- (1) diameter (inches) 2
 - (2) total depth (feet) 130
 - (3) static water level (feet) 15 below top of ground.
 - (4) casing galv (material), (depth)
(size) if telescope see back.
 - (5) screen 5' (length), (depth to top)
2" (size), galv steel (material)
 - (6) pump 2 (HP), (yield gpm)
Elec (type power)
 - (7) electric log no (yes or no)
(organization running log)
 - (8) how well bottom plugged B.W.V.


CODED

DRILLERS REMARKS:

NOV 30 1972

If well telescopes please sketch and show depths.

GROUND LEVEL

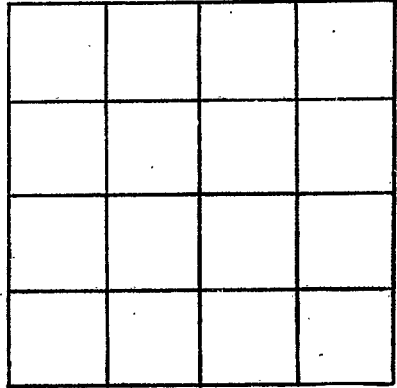

SECTION _____

Please indicate well location X.

ADDITIONAL INFORMATION

If more than one screen,
show locations of each on sketch.