

CODED

MISSISSIPPI  
BOARD OF WATER COMMISSIONERS  
416 North State Street  
Jackson, Mississippi 39201

SCOTT  
B 21  
2/20/78

WATER WELL DRILLERS LOG

2/20/78 19 Griver Drilling Service Scott  
date well completed firm name county well located


LANDOWNER: <u>Oil Development of Utah</u>	description of formations encountered	from	to
<u>Federal 32 # 1-8</u> (mailing address)	<u>Chalk</u>	<u>21</u>	<u>126</u>
	<u>Greenbo</u>	<u>126</u>	<u>147</u>
	<u>Chalk</u>	<u>126</u>	<u>189</u>
	<u>Sand</u>	<u>189</u>	<u>231</u>
	<u>Streambed</u>	<u>231</u>	<u>252</u>
	<u>Sand Shell Chalk Strud</u>	<u>252</u>	<u>357</u>
	<u>Chalk</u>	<u>357</u>	<u>420</u>
	<u>Chalk, Rock, Sand</u>	<u>420</u>	<u>441</u>
	<u>Sand</u>	<u>441</u>	<u>500</u>
	<u>Chalk</u>	<u>500</u>	<u>504</u>
<b>WELL LOCATION:</b> sec. <u>32</u> T. <u>8</u> (N) R. <u>7</u> (E) <u>3</u> miles <u>NE</u> of <u>Morton</u> (distance) (direction) (nearest town)			
<b>WELL PURPOSE:</b> <u>Oil Well Supply</u> (home, irrigation, municipal, industrial)			
<b>WELL COMPLETION DATA:</b>			
(1) diameter (inches) <u>3</u>			
(2) total depth (feet) <u>504</u>			
(3) static water level (feet) <u>100</u> below top of ground.			
(4) casing <u>Steel</u> , <u>504</u> , (material) (depth) <u>3"</u> if telescope see back. (size)			
(5) screen <u>42'</u> <u>452</u> (length) (depth to top) <u>3"</u> , <u>Perforated Pipe</u> (size) (material)			
(6) pump <u>—</u> <u>60</u> (HP) (yield gpm) <u>AC</u> (type power)			
(7) electric log <u>NO</u> (yes or no) <u>NA</u> (organization running log)			
(8) how well bottom plugged <u>change</u> <u>see</u>			
DRILLERS REMARKS:			

RECEIVED  
MAR 30 1978

MISS. BD. OF WATER COMMISSIONERS

If well telescopes please  
sketch and show depths.

GROUND LEVEL

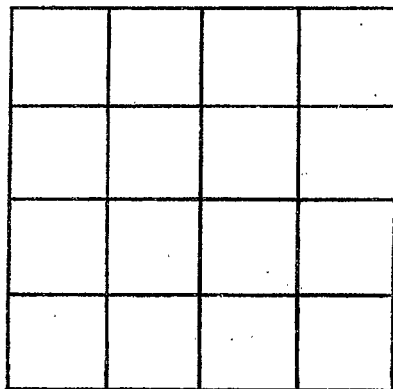

SECTION \_\_\_\_\_

Please indicate well location X.

ADDITIONAL INFORMATION

If more than one screen,  
show locations of each on sketch.