

MISSISSIPPI DEPARTMENT OF NATURAL RESOURCES

Bureau of Land and Water Resources

Southport Mall

P.O. Box 10631

Jackson, Mississippi 39209

WATER WELL DRILLERS LOG

B22
Scott
9-1-85

1985 Brandon Moore Supply Co. Inc.

date well completed

firm name (Please)

county well located

LANDOWNER:
C + C Water Assn.
Forest, Box 39074
(mailing address)

WELL LOCATION:
sec. 11 T. 8 N. R. 7 E. S. 5 W.
10 miles N of Forest
(distance) (direction) (nearest town)

WELL PURPOSE:
(home, irrigation, municipal, industrial)

WELL COMPLETION DATA:

- (1) diameter (inches) 10
- (2) total depth (feet) 1386
- (3) static water level (feet) 132 below top of ground.
- (4) casing Steel, 1252, (material) (depth)
- (size) if telescope see back.
- (5) screen 70', 1322' (length) (depth to top)
- 6" S.S. (size) (material)
- (6) pump 30 HP, 205 (yield gpm)
- Elec. (type power)
- (7) electric log 220 (volts or no)
- MS Bureau of Geology (organization running log)
- (8) how well bottom plugged Rock West Valley

description of formations encountered	from	to
Red Yellow/Orange Sand	0	30
Grey Sand & Clay	30	87
Brown Clay/Brown Clay	87	114
Brown Clay	114	145
Brown Clay/Lignite	145	207
Brown Clay/Shale	207	238
Brown Clay/Sand	238	300
Sand	300	393
Sand/Lignite	393	425
Sand	425	519
Dark Brown Clay	519	550
Sand	550	582
Sand/Brown Clay	582	613
Clay/Sand/Brown Shale	613	642
Shale - Sand	642	674
Hard Rock w/ clay Str	674	705
Hard Shale/Brown Clay	705	737
Hard Shale	737	766
Brown Shale/Lignite	766	797
Brown Shale/Clay & Sand	797	827
Clay/Lignite	827	889
Clay	889	1128
Yellow Sand	1128	1185
Clay	1185	1195
Sand w/ Clay	1195	1245
Clay	1245	1255
Sand	1255	1302
Rock	1302	1318
Sand	1318	1386


RECEIVED
SEP 25 1985

Department of Natural Resources
Bureau of Land & Water Resources

DRILLERS REMARKS:

If well telescopes please sketch and show depths.

GROUND LEVEL

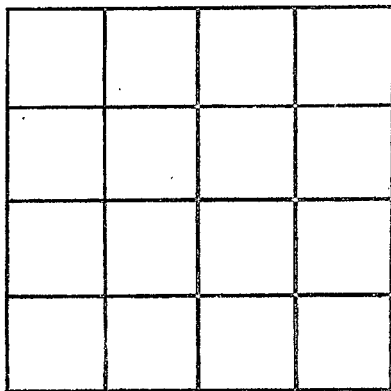

SECTION _____

Please indicate well location X.

ADDITIONAL INFORMATION

If more than one screen,
show locations of each on sketch.