			For Office Use Only:			
County: <u>Scott</u>	Well Driller Report and Well Log		Aquifer:			
Permit #:	Mississippi Department of Environmental Quality		Well #: B-28			
Driller: THOMAS UP, Much		nd Water Resources Box 10631	L. S. Elevation: 438			
Date drilling completed: $5 - 9 - 03$	Jackson, M	IS 39289-0631				
		961-5210 4-6938 (fax)	E-log #:			
·						
State Law requires that this report be prepared by the driller in detail and filed with the Department within 30 days of completion of drilling of the well.						
Well Owner Information		<b>32.54749°</b> - <b>89.55261</b> Latitude: <u>32°32'51</u> " Longitude: <u>89°33'C9</u> "				
Owner Name Rex INGF	9M #1	Latitude: <u>32°32'5</u>	<u> </u> " Longitude: <u>89°33'C9</u> "			
Mailing Address: 1006 Har 355 Method of Lat/Long (circle one): Conventional Survey,						
			d GPS, Survey-grade GPS			
Carthage MS 39051 NE 1/4 Sec 14 Twn 81 Rng 7E						
		Distance Direction <u>3</u> Miles <u>SE</u>	Nearest Town			
Telephone No. (691) 267 -	////	Miles <u>JE</u>	01 <u>LEN4</u>			
Well Data						
Purpose of Well (circle one) Home	Industrial Public Suppl	y Irrigation Fish Cultur	e Other: Poultry			
Date well drilling started: $5 - 09$	- <i>05</i> Da	ate well drilling completed:	5-09-05			
If flowing, method of flow regulation	: Valve Othe	er (describe)				
Static Water Level: 50 feet above or below (circle one) land surface Date measured: 5-09-05						
Method of Measurement (circle one)	-					
Hole depth: <u>100</u> Well depth: <u>100</u> Well grouted to a depth of <u>10</u> feet						
Type of grout (circle one): Cemer		ſix				
Casing length: <u>90</u> feet	Casing diameter: <u>4</u>	inches Type of casir	ng: <u>PVC</u>			
Screen length: <u>10</u> feet Screen diameter: <u>4</u> inches Type of screen: <u>PUC</u>						
Screen slot size: ind	ches Setting depth: Fro	m <u>90</u> feet to _	feet			
Type of completion (circle all applicable): Gravel packets Underreamed Telescoped Open hole Natural Development						
	Other (describe):					
Top of lap pipe or reduction in casing:feet. If telescoped or more than one screen, describe on back of page						
Logs run (circle all applicable): No log run Electric Gamma Ray Density Sonic Neutron Other:						
Name of organization running log(s):						
I certify that the well was drilled, constructed, and completed in accordance with all applicable requirements of the Mississippi Department of Environmental Quality and/or the Mississippi Department of Health regulations and state laws.						
David S. Thomas 0-147 Java & Moman						
Print Name of Water Well Contractor and License No. Signature of Water Well Contractor						

If well telescopes please sketch below and show depths.

۰ ۱

۲

If well telescopes please sketch below and show depths.

Ground Level


Level	Description of Formation	is Encountered From	n To
	Mixed Clay	6	2 12
	fire SANd	12	60
	White sand	Med 60	194
	Roct	94	95
	white SAND	95	100
			_
1		· · · · · · · · · · · · · · · · · · ·	1
	·		
	······		
	······································		

R-28

here I a here here & & &

If more than one screen, show location of each on sketch

Signature of Water Well Contractor

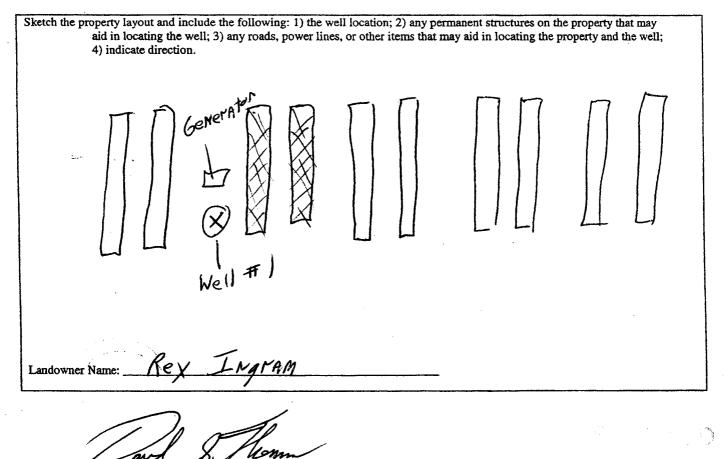

STATE WELL REPORT						
	Part 2		For Office Use Only:			
County: Scott	_ Pump Installe	r's Completion Report	Aquifer:			
Permit #:	Mississippi Departr	nent of Environmental Quality	Well #: B-28			
Driller: THOMAS Dril	ING Office of La	nd and Water Resources	_			
Date completed: 5-,9-05	P.0	D. Box 10631 n, MS 39289-0631	Elevation:			
		01)961-5210				
	(601	354-6938 (fax)				
This report must be prepared by the pump installer in detail and filed with the Department within 30 days of the installation of pump. A copy of Part 1 of this report must be attached to this report.						
Well Owner Information			Well Location			
Owner Name: REX TONGYAM #1		Latitude: 32.54847	Latitude: 32.54749° Longitude: 89.55261°			
Mailing Address: 1006 Hury 355		Method of Lat/Long (circle	Method of Lat/Long (circle one): Conventional Survey,			
			USGS quad Hand-held GPS, Survey-grade GPS			
CAMMAGE	<u>15</u> <u>3705</u> State Zip Code	<sup>1</sup> / <sub>4</sub> <sup>1</sup> / <sub>4</sub> Sec	<u>14 Twn 8N Rng 7E</u>			
Chy	State Zip Code	Distance Direction	n Nearest Town			
Telephone No. (601) 267 - 9719		<u> </u>	<u>3</u> Miles <u>SE</u> of <u>LeNA</u>			
D						
Pump Type Circle one			Power Type Circle one			
Air Lift Jet	Submersible	Diesel Engine Gase	oline Engine Natural Gas			
Bucket Pis	ton Turbine	Electric Motor Har	nd Tractor PTO			
Centrifugal Rot	Flowing Well		er (specify):			
Other (specify):		Horse Power Rating of Mo	tor: <u>2</u>			
Date Pump Installed: 5-	-9-05	Setting Depth: <b>80</b>	feet			
Rated Pump Capacity:	2 Gallons Per Minut	e Number of Stages:	2			
Pump	Test Data	Method of M	easuring Water Level			
Pump Test Data Date Well Tested: 5-9-05			Circle one			
		Air Line Electric M	Measuring Line Steel Tape			
Static Water Level (A): <u>50</u> Feet Below Land Surface		Other (specify):				
Pumping Water Level (B): 56 Feet Below Land Surface						
	6 Feet Below Land Surfa	ce For flowing well, measured	I shut in head:feet			
Test Pumping Rate: <u>~ 3</u>	OGallons Per Minut	e Well yielded	Well yielded GPM with a drawdown of			
Duration of Pump Test (minin	num 4 hours):hou	sfeet afte	rhours of pumping			
I HEREBY CERTIFY that the above statements are true to the best of my knowledge.						
DAUID S. Thomps 0-141 Print Name of Pump Installer and License No. (if applicable) Signature of Pump Installer						

• • •