

MISSISSIPPI DEPARTMENT OF NATURAL RESOURCES

Bureau of Land and Water Resources

Southport Mall

P.O. Box 10631

Jackson, Mississippi 39209

WATER WELL DRILLERS LOG

Scott
B2000

11/12/82 19 82 Thomas & Son
date well completed firm name

Scott
county well located

LANDOWNER: Keith Lunn

description of formations encountered

from to

PT 1
Lena MS
(mailing address)

<u>Red Dirt</u>	<u>0</u>	<u>10</u>
<u>White Chalk</u>	<u>10</u>	<u>14</u>
<u>White Sand + Chalk</u>	<u>14</u>	<u>28</u>
<u>Grey Sand + Chalk</u>	<u>28</u>	<u>44</u>
<u>Grey Sand</u>	<u>44</u>	<u>88</u>
<u>White Sand</u>	<u>88</u>	<u>138</u>

WELL LOCATION:

sec. 9 T. 8 N. R. 7 E
S W
2 miles SE of Lena
(distance) (direction) (nearest town)

WELL PURPOSE:
(home, irrigation, municipal, industrial)

WELL COMPLETION DATA:

- (1) diameter (inches) 2"
- (2) total depth (feet) 138'
- (3) static water level (feet) 18 ^{below}/_{above} top of ground.
- (4) casing PVC 138'
(material) (depth)
2"
(size) if telescope see back.
- (5) screen 10 138'
(length) (depth to top)
2" PVC
(size) (material)
- (6) pump 3/4 8'
(HP) (yield gpm)
Electric
(type power)
- (7) electric log no
(yes or no)

(organization running log)

(8) how well bottom plugged free

DEPT. OF NATURAL RESOURCES
BUREAU OF LAND & WATER RESOURCES


DEC 17 1982

DRILLERS REMARKS:

RECEIVED

If well telescopes please
sketch and show depths.

GROUND LEVEL

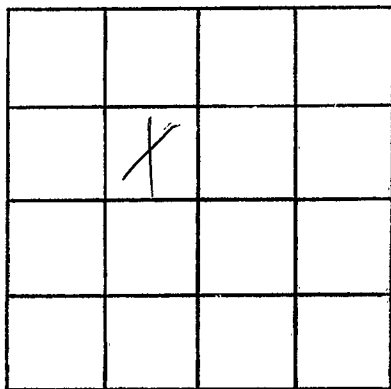

SECTION _____

Please indicate well location X.

ADDITIONAL INFORMATION

If more than one screen,
show locations of each on sketch.