

MISSISSIPPI DEPARTMENT OF NATURAL RESOURCES

Bureau of Land and Water Resources

Southport Mall

P.O. Box 10631

Jackson, Mississippi 39209

WATER WELL DRILLERS LOG

SCOTT
B 2001

date well completed 11/15 1982 firm name THOMAS & SON county well located SCOTT

LANDOWNER: <u>Barney Sessoms</u> <u>RH1</u>	description of formations encountered	from	to
<u>Lena MS</u> (mailing address)	<u>Red Dirt</u>	<u>0</u>	<u>6</u>
	<u>Red Sand</u>	<u>6</u>	<u>34</u>
	<u>White Sand</u>	<u>34</u>	<u>50</u>
	<u>White Sand Some Chalk</u>	<u>50</u>	<u>83</u>
WELL LOCATION: sec. <u>9</u> T <u>80</u> N R <u>20</u> E S W <u>2</u> miles <u>SE</u> of <u>Lena</u> (distance) (direction) (nearest town)			
WELL PURPOSE: (home, irrigation, municipal, industrial)			
WELL COMPLETION DATA:			
(1) diameter (inches) <u>4"</u>			
(2) total depth (feet) <u>83</u>			
(3) static water level (feet) <u>43</u> <u>below</u> <u>above</u> top of ground.			
(4) casing <u>PC</u> , <u>83'</u> (material) (depth) <u>4"</u> (size) if telescope see back.			
(5) screen <u>20'</u> , <u>63'</u> (length) (depth to top) <u>4"</u> , <u>PC</u> (size) (material)			
(6) pump <u>3/4</u> , <u>16</u> (HP) (yield gpm) <u>Electric</u> (type power)			
(7) electric log <u>NO</u> (yes or no) (organization running log)			
(8) how well bottom plugged <u>Good</u>			
DRILLERS REMARKS:			


DEPT. OF NATURAL RESOURCES
BUREAU OF LAND & WATER RESOURCES

DEC 17 1982

RECEIVED

If well telescopes please sketch and show depths.

GROUND LEVEL

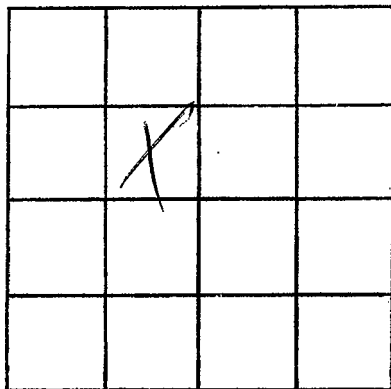

SECTION _____

Please indicate well location X.

ADDITIONAL INFORMATION

If more than one screen,
show locations of each on sketch.