

MISSISSIPPI DEPARTMENT OF NATURAL RESOURCES

Bureau of Land and Water Resources

Southport Mall

P.O. Box 10631

Jackson, Mississippi 39209

WATER WELL DRILLERS LOG

7-26 1984 Thomas & son SCOTT CO
 date well completed firm name county well located

LANDOWNER: Roger Rinehart

description of formations encountered

from

to

Lena Miss
 (mailing address)

Red Dirt 0 4
 Grey Dirt 4 10
 Grey Chalk 10 26
 Grey Chalk & fine sand 26 48
 White coarse sand 48 103

WELL LOCATION:

sec. 9 T. 8 N R. 2 E
 S W
 2 miles SE of Lena
 (distance) (direction) (nearest town)

WELL PURPOSE:

(home, irrigation, municipal, industrial)

WELL COMPLETION DATA:

- (1) diameter (inches) 4"
 (2) total depth (feet) 103'
 (3) static water level (feet) 40' below top of ground.
 (4) casing PVC 103'
 (material) (depth)
 4" If telescope see back.
 (size)
 (5) screen 10' 93'
 (length) (depth to top)
 4" PVC
 (size) (material)
 (6) pump 1/2 16
 (HP) (yield gpm)
 Electric
 (type power)
 (7) electric log NO
 (yes or no)

(organization running log)

- (8) how well bottom plugged Screen

DRILLERS REMARKS:


DEPT. OF NATURAL RESOURCES
 BUREAU OF LAND & WATER RESOURCES

AUG 13 1984

RECEIVED

If well telescopes please
sketch and show depths.

GROUND LEVEL

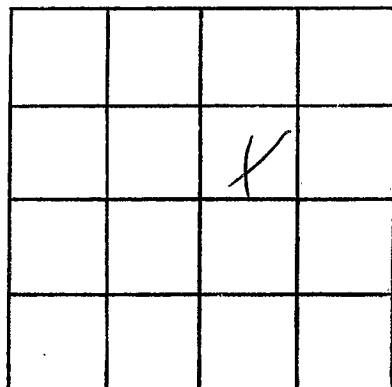

SECTION _____

Please indicate well location X.

ADDITIONAL INFORMATION

If more than one screen,
show locations of each on sketch.