

MISSISSIPPI DEPARTMENT OF NATURAL RESOURCES

Bureau of Land and Water Resources

Southport Mall

P.O. Box 10631

Jackson, Mississippi 39209

WATER WELL DRILLERS LOG

SCOTT
B 2005

10-1- 1984
date well completed

84 THOMAS + 50d
firm name

SCOTT
county well located

LANDOWNER: Charles Rhineland

description of formations encountered

from to

<u>Red sand</u>	<u>0</u>	<u>6</u>
<u>White sand</u>	<u>6</u>	<u>24</u>
<u>White C sand</u>	<u>24</u>	<u>73</u>

Leona ms
(mailing address)

WELL LOCATION:

sec. 9 T. 8 S. R. 70 E. W. W
2 miles SE of Leona
(distance) (direction) (nearest town)

WELL PURPOSE:

(Home, Irrigation, municipal, industrial)

WELL COMPLETION DATA:

- (1) diameter (inches) 4"
- (2) total depth (feet) 73'
- (3) static water level (feet) 20 below top of ground.
- (4) casing PVC 73'
(material) (depth)
4" if telescope see back.
(size)
- (5) screen 10' 63'
(length) (depth to top)
4" (size) PVC (material)
- (6) pump 1 18
(HP) (yield gpm)
Electric
(type power)
- (7) electric log NO
(yes or no)

(organization running log)

(8) how well bottom plugged Sealed

DRILLERS REMARKS:


DEPT. OF NATURAL RESOURCES
BUREAU OF LAND & WATER RESOURCES

DEC 21 1984

RECEIVED

If well telescopes please sketch and show depths.

GROUND LEVEL

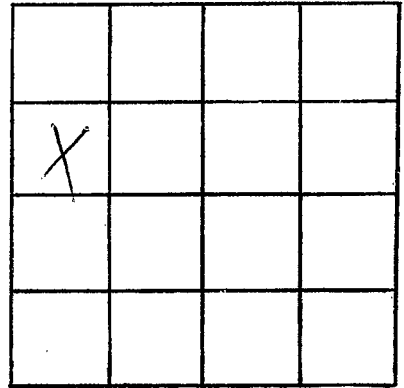

SECTION _____

Please indicate well location X.

ADDITIONAL INFORMATION

If more than one screen,
show locations of each on sketch.