

MISSISSIPPI DEPARTMENT OF NATURAL RESOURCES

Bureau of Land and Water Resources

P.O. Box 10631

Jackson, Mississippi 39209

WATER WELL DRILLERS LOG

COUNTY WELL LOCATED <i>Scott</i>	
WELL NUMBER <i>13 2007</i>	CODED
DATE WELL COMPLETED <i>9-4-87</i>	

PERMIT NUMBER
NAME OF DRILLING FIRM <i>Thomas Drilling</i>
<i>Carthage, MS</i>

NAME & MAILING ADDRESS OF LANDOWNER <i>Frank Stowers</i>			
<i>Rt. 3 Box 116-4</i>			
<i>Forest, MS 39074</i>			
WELL LOCATION:	SEC	TOWNSHIP	RANGE
	<i>13</i>	<i>6</i>	<i>9</i>
		<i>S</i>	<i>W</i>
DISTANCE	DIRECTION	NEAREST TOWN	
<i>3</i>	<i>N</i>	<i>William</i>	
OTHER LANDMARK <i>1/2 mile of church</i>			
WELL PURPOSE: Home, Irrigation, Municipal, Industrial, Fish Pond, etc. <i>Home</i>			

PUMP DATA			
PUMP TYPE (Circle One): <input checked="" type="checkbox"/> Submersible, Turbine, Jet, Flowing Well, Other (Describe) <i>1-H.P. Goulds</i>			
POWER TYPE (Circle One): <input checked="" type="checkbox"/> Electric, Tractor, Diesel, Gasoline, Butane, Other (Describe) <i>220</i>			
Pump Capacity (GPM)	No. of Stages	Setting Depth	
<i>25</i>	<i>10</i>	<i>90'</i> FT.	
PUMP TEST			
Well yielded <i>25</i> GPM with			
a drawdown of <i>18</i> ft.			
after <i>1</i> hours of pumping			

WELL DATA		
Well Depth <i>100'</i>	Casing Diameter (In.) <i>4"</i>	Casing Length (Ft.) <i>90'</i>
Type of Casing <i>PVC</i>	Hole Depth <i>100'</i>	Depth to Static Water Level <i>40'</i>
TYPE OF COMPLETION: (Circle One or More): Gravel Packed, Underreamed, Telescoped, Natural Development, Open Hole, Other (Describe) <i>Sand Packed</i>		
Top of Lap Pipe or Reduction in Casing <i>—</i>		
FEET <input type="checkbox"/> IF TELESCOPED OR MORE THAN ONE SCREEN: USE BACK PAGE		

LOG DATA	
TYPE OF LOG RUN (Circle One): <input checked="" type="checkbox"/> No Log Run, Electric, Gamma Ray, Density, Sonic, Neutron, Other (Describe)	
Name of Organization Running Log	


SCREEN DATA		
Diameter - Inches <i>4"</i>	Length - Feet <i>10'</i>	Slot Size - Inches <i>.10</i>
Screen Type <i>PVC</i>	Depth to Bottom - Feet <i>100'</i>	

GEOLOGIC DATA (Office Use Only)			
Surface Elev.	Geologic Unit	Unit Thickness	Depth to Top
Subs. SWL	Date	Analysis	Aquifer Test
Driller's Remarks			

DESCRIPTION OF FORMATIONS ENCOUNTERED	FROM	TO	FORMATIONS (Continued)	FROM	TO
<i>Dirt</i>	<i>0</i>	<i>4</i>	RECEIVED <i>150</i>		
<i>Dirt & sand</i>	<i>4</i>	<i>40</i>			
<i>White sand</i>	<i>40</i>	<i>100</i>			
			OCT 13 1987		
			Department of Natural Resources Bureau of Land & Water Resources		
IF MORE SPACE IS NEEDED, USE BACK					

If well telescopes please sketch and show depths.

GROUND LEVEL

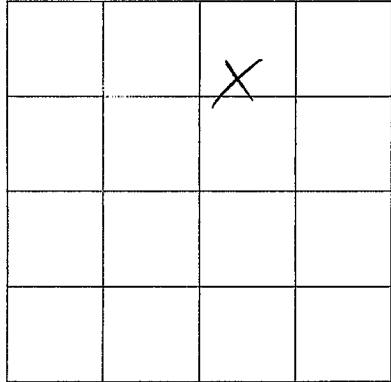

SECTION 13

Please indicate well location X.

ADDITIONAL INFORMATION

If more than one screen,
show location of each on sketch.