

Scott

SE NE 32 8 N 8 E

MISSISSIPPI BOARD OF WATER COMMISSIONERS
416 North State Street
Jackson, Mississippi 39201

el No. 63

well # 1
v c 2
3-67
Elec Log
3-7-67

WATER WELL DRILLERS LOG

LEACH DRILLING SCOTT

date well completed

firm name

county well located

LANDOWNER: H. H. water
Associates
Hopewell, Miss
(mailing address)

description of formations encountered	from	to
Red clay	0	20
Sand	20	110
Sand & clay	110	200
Sand & clay	200	240
Rock	240	245
Sand & clay	245	246
Sand (cut, gravel)	240	420
Sand & clay	420	660
Sand	660	610
Sand & clay	610	760
Rock	760	762
Clay	762	795
Rock	795	800
Sand	800	910
Sand & clay	910	960
Sand	960	1045
Clay	1045	1120

WELL LOCATION:
sec. 32 T. B S. R. 8 W.
(distance) miles of (direction) of (nearest town)

WELL PURPOSE: Test
(home, irrigation, municipal, industrial)



WELL COMPLETION DATA:
(1) diameter (inches) 4 x 2"
(2) total depth (feet) 1120
(3) static water level (feet) 89 below top of ground.
(4) casing 4" 2 5/8" (material) (depth)

(size) if telescope see back.
(5) screen 20, 1030 (length) (depth to top)
2 1/2" (size) (material) Standard 500
(6) pump 3 HP (HP) 55 (yield gpm)

E. L. L. L. (type power)
(7) electric log yes (yes or no)
Miss. Geological (organization running log)

(8) how well bottom plugged

DRILLERS REMARKS:

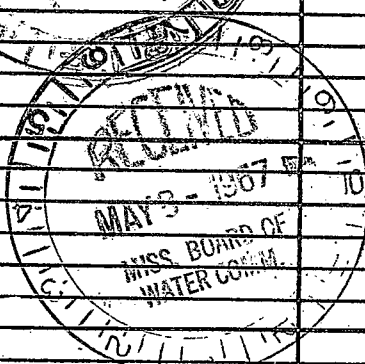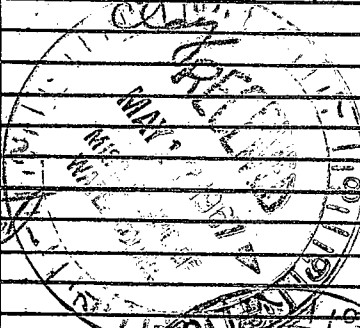

If well telescopes please sketch and show depths.

GROUND LEVEL

SE, NE

			X

SECTION _____

Please indicate well location X.

ADDITIONAL INFORMATION

If more than one screen, show locations of each on sketch.