

SE SW NE 32 8 8

SCOTT

el log 67

MISSISSIPPI BOARD OF WATER COMMISSIONERS

416 North State Street

Jackson, Mississippi 39201

WATER WELL DRILLERS LOG

LEACH Drilling SCOTT

well # 3
VC 3
5-67
Elec Log

date well completed

firm name

county well located

LANDOWNER: H & H water

description of formations encountered

from

to

Assoc.

Hogswallow, Miss
(mailing address)

red clay

0 40

sand & clay

40 710

sand

710 720

sand clay & gravel

720 740

sand

740 770

blue clay

770 820

sand

820 840

clay

840 870

sand

870 900

sand

900 910

sand & clay

910 930

WELL LOCATION:

sec 4 100 R E
32 S
1/4 mile (distance) of Hogswallow (direction) of Hogswallow (nearest town)

WELL PURPOSE:

res (home, irrigation, municipal, industrial)

WELL COMPLETION DATA:

(1) diameter (inches) 4 x 2

(2) total depth (feet) 930

(3) static water level (feet) 96 below top of ground

(4) casing 4" (material) 210 (depth)

2" (size) 910 (material)

(5) screen 20' (length) 890 (depth to top)

2 1/2" (size) 5-5 (material)

(6) pump 3 (HP) 55 (yield gpm)



Electric (type power)

(7) electric log yes (yes or no)

U.S. (organization running log)

(8) how well bottom plugged

DRILLERS REMARKS:

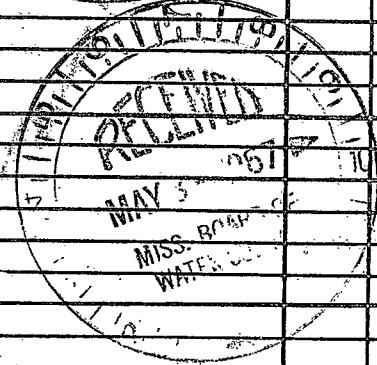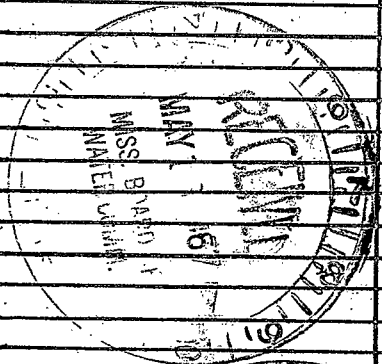

If well telescopes please sketch and show depths.

GROUND LEVEL

SECTION _____

Please indicate well location X.

ADDITIONAL INFORMATION

If more than one screen, show locations of each on sketch.