

SCOTT
C4
4-11-43

WATER WELL DRILLERS LOG

CODED

Date: 4-11, 1963, Driller: Ray Corp County: Scott
(Name)

(1) Owner of Land: Vernard Murais
(Name)
Front Rt NE
(Address)
24 88

(2) Location: 1/4, 1/4, Sec. T2 R
3 miles N of Stul
(distance) (direction) (Nearest Town)

(3) Topography: V
(Hilly) (Flat) (Level)

(4) Purpose of Well:
(Domestic Irrigation
Municipal, Industrial, Other)

Description & Color of Materials Sand, Clay, Red Clay, Shell, etc.	Thick- ness Feet	Depth Feet
<u>0-15' Red Clay</u>		
<u>15-18 Yellow Sand</u>		
<u>18-22 Brown Chalk</u>		
<u>22-45 White Sand</u>		

CODED

Information upon completion of well:

(1) Diameter _____ inches.


(2) Total Depth 45 feet.

(3) Water Level 14' feet below top of ground.

(4) Cased to _____, Size _____.

(5) Screen: Size _____, Length _____.

(6) Were any formations sealed against pollution?
_____ yes, _____ no.

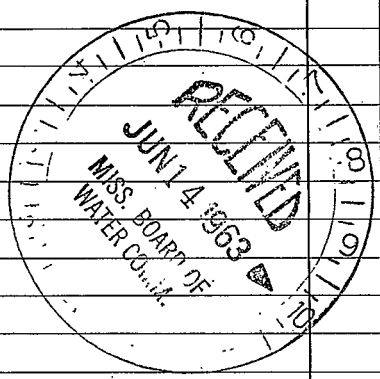

If YES depth of formation _____

Why _____

Drillers Remarks:
Common well drilling
Subsidiary well

(Use Back Side)

Well No.

