

SC5
4-18-62

T
WATER WELL DRILLERS LOG

Date: 4-18, 1962, Driller: Harmon Drilling Co. County Scott
(Name)

(1) Owner of Land: Harmon Drilling Co.
(Name)
Harmon Drilling Co.
(Address)

(2) Location: $\frac{1}{4}$, $\frac{1}{4}$, Sec. 9 8N 2E
T R

4 miles N, of Harmonville
(distance) (direction) (Nearest Town)

(3) Topography: Hilly
(Hilly) (Flat) (Level)

(4) Purpose of Well: Farm
(Domestic Irrigation
Municipal, Industrial, Other)

Description & Color of Materials Sand, Clay, Red Clay, Shell, etc.	Thick- ness Feet	Depth Feet.
Red clay	15	15
White - grey sand	28	43
Grey clay	29	72
Grey pebbled sand		
Shells	5	77
Grey pebbled sand	5	82
Grey clay	18	100
Light grey sand	22	122

Information upon completion of well:

(1) Diameter 2 inches.

(2) Total Depth 292 1/2 feet.

(3) Water Level 127 feet below top of ground.


(4) Cased to 182 1/2, Size 2

(5) Screen: Size 2, Length 10'

(6) Were any formations sealed against pollution?
_____ yes, no.

If YES depth of formation _____
Why _____

Drillers Remarks: _____

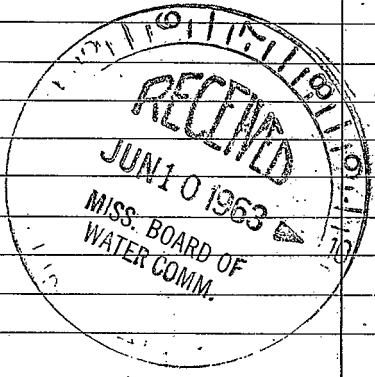

(Use Back Side)

Well No.

