

SCOTT

6 C 6
10-11-62

WATER WELL DRILLERS LOG

Date: 10/11, 1962, Driller: Fast Dig Buc County Scott
(Name)

(1) Owner of Land: A. L. Bann
(Name)
Harperville, Miss
(Address)

(2) Location: 1/4, 1/4, Sec. 35 T 8E R 1
9 miles north of Fast
(distance) (direction) (Nearest Town)

(3) Topography: _____
(Hilly) (Flat) (Level)

(4) Purpose of Well: Home
(Domestic Irrigation
Municipal, Industrial, Other)

Description & Color of Materials Sand, Clay, Red Clay, Shell, etc.	Thick- ness Feet	Depth Feet
<u>Brown Clay</u>		<u>18</u>
<u>Red Sand</u>		<u>32</u>
<u>Sand</u>		<u>72</u>
<u>Sand + Shls Clay</u>		<u>92</u>
<u>Sand</u>		<u>118</u>

Information upon completion of well:

(1) Diameter 2" inches.

(2) Total Depth 118 feet.

(3) Water Level 23 feet below top of ground.

(4) Cased to 113, Size 2"


(5) Screen: Size 2", Length 5ft.

(6) Were any formations sealed against pollution?
_____ yes, no.

If YES depth of formation _____

Why _____

Drillers Remarks: _____

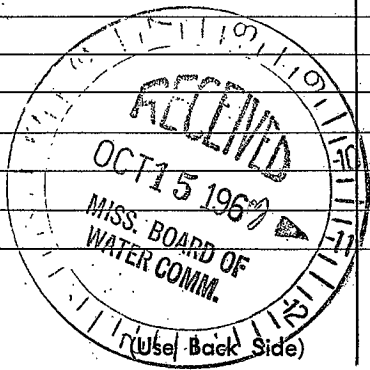

Well No.

