

SCOTT

MISSISSIPPI BOARD OF WATER COMMISSIONERS

C7
1-11-64

WATER WELL DRILLERS LOG

Date: 1/11, 1964, Driller: James T. Drilling, Inc. County: Scott
(Name)

(1) Owner of Land: John E. Thrash
(Name)
Harperville, Miss.
(Address)

(2) Location: 1/4, 1/4, Sec. 9 SW 8E, T. R.
4 miles North, of Harperville
(distance) (direction) (Nearest Town)

(3) Topography: Flat
(Hilly) (Flat) (Level)

(4) Purpose of Well: Chickens
(Domestic Irrigation
Municipal, Industrial, Other)

Description & Color of Materials Sand, Clay, Red Clay, Shell, etc.	Thick- ness Feet	Depth Feet
<u>Red Clay</u>		<u>42</u>
<u>Blue Clay</u>		<u>128</u>
<u>Rock</u>		<u>132</u>
<u>Clay & Shells</u>		<u>142</u>
<u>Hardy Shell</u>		<u>152</u>
<u>Green Sand</u>		<u>172</u>
<u>Good Sand</u>		<u>192</u>

Information upon completion of well:

(1) Diameter 2 inches.

(2) Total Depth 192 feet.

(3) Water Level 80 feet below top of ground.

(4) Cased to 181, Size 2"


(5) Screen: Size 2", Length 11

(6) Were any formations sealed against pollution?
_____ yes, X no.

If YES depth of formation _____

Why _____

Drillers Remarks: _____

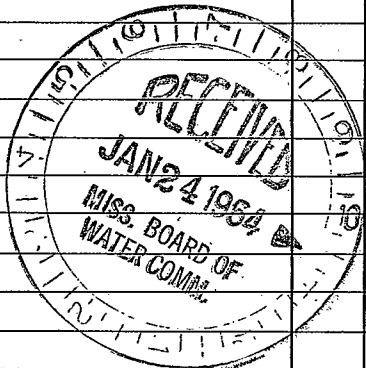

(Use Back Side)

Well No.

