

SCOTT MISSISSIPPI BOARD OF WATER COMMISSIONERS

S C8  
7-14-65

WATER WELL DRILLERS LOG

Date: 7/14, 1965, Driller: Forest Drilling Co. Scott  
(Name)

(1) Owner of Land: R. L. Ware, Jr.  
(Name)  
Hagermiller, Miss.  
(Address)

(2) Location: 1/4, 1/4, Sec. 33 8 1/2 E  
T. R  
5 miles North of Forest  
(distance) (direction) (Nearest Town)

(3) Topography: \_\_\_\_\_  
(Hilly) (Flat) (Level)

(4) Purpose of Well: Home  
(Domestic Irrigation  
Municipal, Industrial, Other)

Description & Color of Materials Sand, Clay, Red Clay, Shell, etc.	Thick- ness Feet	Depth Feet
<u>Brown Clay</u>	<u>0</u>	<u>20</u>
<u>Clay + fine sand</u>	<u>3</u>	<u>32</u>
<u>7 sand + 1/2 clay</u>	<u>4</u>	<u>42</u>
<u>7 sand + clay</u>	<u>9</u>	<u>92</u>
<u>7 sand + 5/8 clay</u>	<u>10</u>	<u>102</u>
<u>Good sand</u>	<u>11</u>	<u>112</u>

Information upon completion of well:

(1) Diameter 2 inches.

(2) Total Depth 110 feet.

(3) Water Level 20 ft feet below top of ground.

(4) Cased to 100, Size 2"


(5) Screen: Size 2", Length 10 ft

(6) Were any formations sealed against pollution?  
\_\_\_\_\_ yes,  no.

If YES depth of formation \_\_\_\_\_

Why: \_\_\_\_\_

Drillers Remarks: \_\_\_\_\_

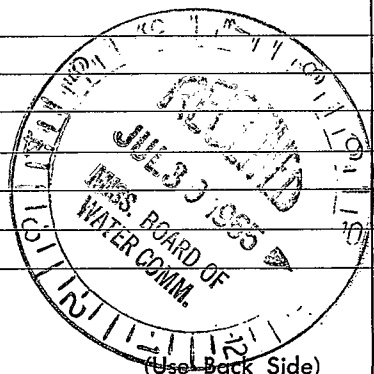

Well No.

