

SCOTT

MISSISSIPPI BOARD OF WATER COMMISSIONERS

3-3-66

WATER WELL DRILLERS LOG


Date: 3-3, 1966, Driller: LEACH County: Scott

(1) Owner of Land: D.C. Smith (Name)
Harpersville Miss (Address)
(2) Location: 1/4, 1/4, Sec. 33 T. R.
1/2 miles North of Harpersville
(3) Topography: (Hilly) (Flat) (Level)
(4) Purpose of Well: (Domestic Irrigation) (Municipal, Industrial, Other)

Table with 3 columns: Description & Color of Materials, Thickness Feet, Depth Feet. Rows: Clay (20), Sandy clay (30), Sand (30)

Information upon completion of well:

(1) Diameter 4 inches.
(2) Total Depth 80 feet.
(3) Water Level 30 feet below top of ground.
(4) Cased to 70, Size
(5) Screens: Size 2 1/2, Length 10'
(6) Were any formations sealed against pollution?
yes, no.

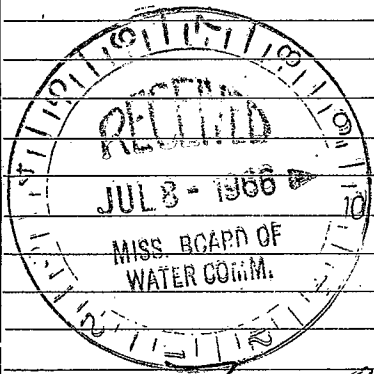

If YES depth of formation
Why
Drillers Remarks: Fish ponds
Yield in gpm: 45
Size pump: 3 HP Sub.
Type power:

Latel 80

