

MISSISSIPPI
 BOARD OF WATER COMMISSIONERS
 416 North State Street
 Jackson, Mississippi 39201

WATER WELL DRILLERS LOG

CODED

Scott
 C 12
 1-30-68
 1-30

1-30 date well completed 1965 Common Drilling firm name Scott county well located

LANDOWNER: SO Braun

description of formations encountered

from to

Rt # 4 Forest
Miss
 (mailing address)

Clay 0 160

WELL LOCATION:

sec. 26 T. 6 N. R. 8 E.
 S. W.
2 miles N of Harpville
 (distance) (direction) (nearest town)

Fine sand
& clay lumps 160 190

WELL PURPOSE: Home
 (home, irrigation, municipal, industrial)

WELL COMPLETION DATA:

(1) diameter (inches) 2"
 (2) total depth (feet) 190
 (3) static water level (feet) 60 below above
 top of ground.

(4) casing Steel, 84
 (material) (depth)
1 1/4 if telescope see back.
 (size)

(5) screen brass,
 (length) (depth to top)
 (size) (material)

(6) pump 1 1/2 290"
 (HP) (yield gpm)
 (type power)

(7) electric log _____
 (yes or no)
 (organization running log)

(8) how well bottom plugged _____

CODED


FEB 12 1963

MISS. BD. OF
 WATER COMM.

DRILLERS REMARKS: Open
bottom

If well telescopes please sketch and show depths.

GROUND LEVEL

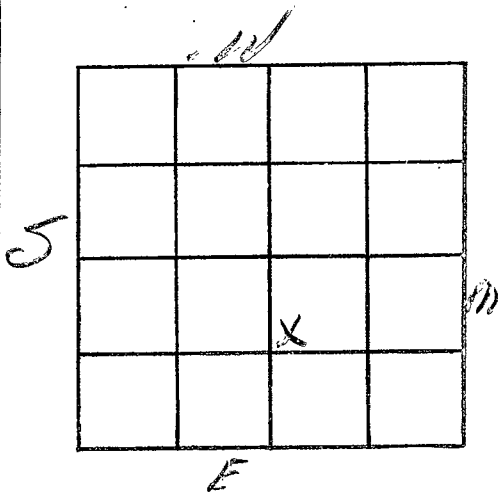

SECTION 28

Please indicate well location X.

ADDITIONAL INFORMATION

If more than one screen, show locations of each on sketch.