

MISSISSIPPI
BOARD OF WATER COMMISSIONERS
416 North State Street
Jackson, Mississippi 39201

CODED

WATER WELL DRILLERS LOG

6-19 1968 Concrete Drilling Service Scott
date well completed firm name county well located

LANDOWNER: Eddie Cager

description of formations encountered

from to

Harperville, General Dd

<u>Clay</u>	<u>0</u>	<u>140</u>
<u>Sand Fine</u>	<u>140</u>	<u>162</u>
<u>Sand Fairly Coarse</u>	<u>162</u>	<u>175</u>

Miss
(mailing address)

WELL LOCATION:

sec. 22 T. 8 N R. 8 E
S W
2 miles N.E. of Harperville
(distance) (direction) (nearest town)

WELL PURPOSE: Home
(home, irrigation, municipal, industrial)

WELL COMPLETION DATA:

- (1) diameter (inches) 2
- (2) total depth (feet) 170
- (3) static water level (feet) 90 below above top of ground.
- (4) casing Steel, 165
(material) (depth)
- if telescope see back.
(size)
- (5) screen 5, 165
(length) (depth to top)
- 2", 5/8
(size) (material)
- (6) pump 1" 350 GPH
(HP) (yield gpm)
- (type power)
- (7) electric log No
(yes or no)
- (organization running log)
- (8) how well bottom plugged

CODED


FEB 12 1969

MISS. BD. OF
WATER COMM.

DRILLERS REMARKS:

If well telescopes please sketch and show depths.

GROUND LEVEL

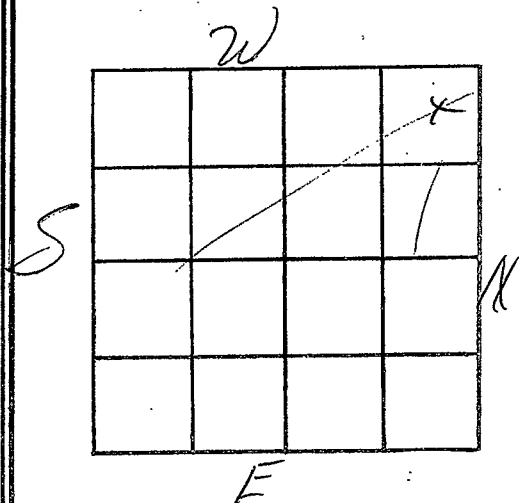

SECTION 22

Please indicate well location X.

ADDITIONAL INFORMATION

If more than one screen, show locations of each on sketch.