

SCOTT  
C 16  
9-30-71

MISSISSIPPI  
BOARD OF WATER COMMISSIONERS  
416 North State Street  
Jackson, Mississippi 39201

WATER WELL DRILLERS LOG

**COPIED**

Sept-30 1971  
date well completed

WilKerson Drilling  
firm name

SCOTT  
county well located

LANDOWNER:	description of formations encountered	from	to
Jean Stubbs Townsend Harperville Miss (mailing address)			
WELL LOCATION:			
sec. 27 T 8 N R 8 E S W			
4 miles N.E. of Harperville (distance) (direction) (nearest town)			
WELL PURPOSE: home (home, irrigation, municipal, industrial)			
WELL COMPLETION DATA:			
(1) diameter (inches) 2			
(2) total depth (feet) 302			
(3) static water level (feet) 80 below top of ground.			
(4) casing GALV. 294 (material) (depth)			
(size) if telescope see back.			
(5) screen 8' 302 (length) (depth to top)			
2" Brass (size) (material)			
(6) pump 1 hp 8 (HP) (yield gpm)			
Elec (type power)			
(7) electric log No (yes or no)			
(organization running log)			
(8) how well bottom plugged 2" BWU			
DRILLERS REMARKS:			

**COPIED**


Miss. Bd. of  
Water Comm.

OCT 10 1971

Miss. Bd. of  
Water Comm.

If well telescopes please sketch and show depths.

GROUND LEVEL

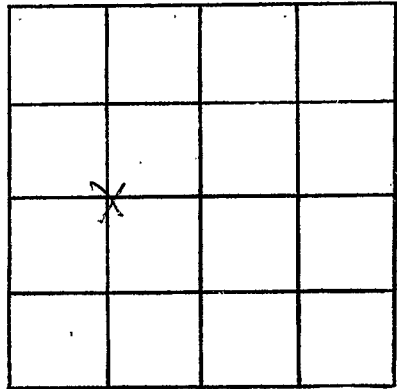

SECTION 27

Please indicate well location X.

ADDITIONAL INFORMATION

If more than one screen,  
show locations of each on sketch.