

SCOTT  
C17  
1-9-74

MISSISSIPPI  
BOARD OF WATER COMMISSIONERS  
416 North State Street  
Jackson, Mississippi 39201  
CODED

WATER WELL DRILLERS LOG

1/9 1974 Forest Drilling Scott  
date well completed firm name county well located

LANDOWNER:	description of formations encountered	from	to
Harvey Coleman	Red Clay	0	10
Hillsboro Miss (mailing address)	Clay + silt Sand	10	40
	1 clay	40	61
	Silt & Shale + clay	61	81
	Fine Sand	81	137
<b>WELL LOCATION:</b>			
sec. 31 T 8 N R 8 E 3 miles N Hillsboro (distance) (direction) (nearest town)			
<b>WELL PURPOSE:</b> (home, irrigation, municipal, industrial)			
<b>WELL COMPLETION DATA:</b>			
(1) diameter (inches) 2			
(2) total depth (feet) 137			
(3) static water level (feet) 62 below top of ground.			
(4) casing 2 Hdw. 137 (material) (depth)			
_____ If telescope see back. (size)			
(5) screen 5 132 (length) (depth to top)			
2 5/8 #80 (size) (material)			
(6) pump 3/4 50 (HP) (yield gpm)			
elec. (type power)			
(7) electric log No (yes or no)			
_____ No (organization running log)			
(8) how well bottom plugged B.W. valve			
<b>DRILLERS REMARKS:</b>			


CODED

RECEIVED  
JAN 22 1974

MISS. BD. OF WATER COMM.

If well telescopes please sketch and show depths.

GROUND LEVEL

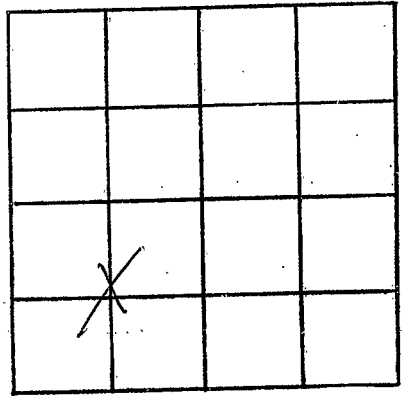

SECTION 35

Please indicate well location X.

ADDITIONAL INFORMATION

If more than one screen,  
show locations of each on sketch.