

MISSISSIPPI DEPARTMENT OF NATURAL RESOURCES
Bureau of Land and Water Resources
 Southport Mall
 P.O. Box 10631
 Jackson, Mississippi 39209
WATER WELL DRILLERS LOG

Scott
C 18
1-11-90

Coded

January 11 1990 Layne Central Co. Scott
 date well completed firm name county well located

LANDOWNER: H & H Water Association
P.O. Box 40
Harperville, MS 39080
 (mailing address)

WELL LOCATION: SW 1/4 of SE 1/4 of SW 1/4
 sec. 33 T. 8 N R. 8 E
8 W
 (distance) miles (direction) of (nearest town)

WELL PURPOSE: Domestic
 (home, irrigation, municipal, industrial)

WELL COMPLETION DATA:

- (1) diameter (inches) 12"
- (2) total depth (feet) 946'
- (3) static water level (feet) 181' below above top of ground.
- (4) casing STEEL, 995'
 (material) (depth)
12" if telescope see back.
 (size) 72" of 8"
- (5) screen 50', 891'
 (length) (depth to top)
8", Stainless Steel Rod
 (size) (material) Base
- (6) pump 600, 400
 (HP) (yield gpm)
230 volts
 (type power)
- (7) electric log Yes
 (yes or no)
Layne Central Co.
 (organization running log)
- (8) how well bottom plugged Back
Pressure Valve

description of formations encountered	from	to
Yellow Clay	0	35'
Sand & lignite & Clay	35'	110'
Sand	110'	147'
Clay	147'	220'
Clay & Sand streaks	220'	310'
Sand	310'	414'
Clay	414'	432'
Sand	432'	470'
Shale	470'	770'
Hard Shale	770'	780'
Shale	780'	790'
Sand & Shale streaks	790'	810'
Shale	810'	830'
Fine Sand	830'	840'
Clay & Sand streaks	840'	875'
Sand & Clay	875'	945'
Clay & Sand streaks	945'	1040'
Clay	1040'	1059'

RECEIVED


MAR 21 1991

Dept. of Environmental Quality
 Bureau of Land & Water Resources

DRILLERS REMARKS: Permit #
MS-GW-04804

If well telescopes please sketch and show depths.

GROUND LEVEL

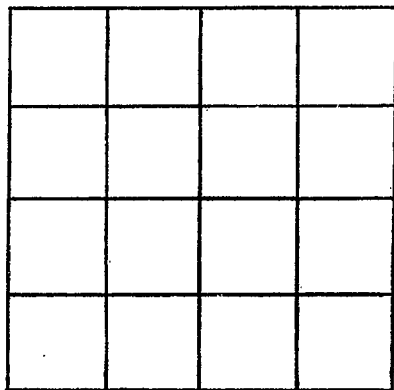

SECTION _____

Please indicate well location X.

ADDITIONAL INFORMATION

If more than one screen,
show locations of each on sketch.