

SCOTT  
 C 27  
 12-29-69

MISSISSIPPI  
 BOARD OF WATER COMMISSIONERS  
 416 North State Street  
 Jackson, Mississippi 39201

CODED

CODED

WATER WELL DRILLERS LOG

13/29 1969 date well completed      Frost Drilling Scott firm name      county well located


LANDOWNER:	description of formations encountered	from	to
(mailing address)			
Johny Joyce Harperville, Miss.	Red clay	0	20
	Clay + sand	20	87
	Clay + silt rock	87	102
	Clay	102	163
	Clay + silt rock	163	184
	Clay + silt	184	212
	Fine sand	212	245
	Fine sand	245	276
	Clay	276	287
<b>WELL LOCATION:</b> sec. <u>17</u> T. <u>8</u> N. R. <u>8</u> E. of <u>Harperville</u> (distance) miles (direction) (nearest town)			
<b>WELL PURPOSE:</b> <u>None</u> (home, irrigation, municipal, industrial)			
<b>WELL COMPLETION DATA:</b>			
(1) diameter (inches) <u>2"</u>			
(2) total depth (feet) <u>275'</u>			
(3) static water level (feet) <u>113'</u> below above top of ground.			
(4) casing <u>Steel</u> , <u>260'</u> (material) (depth)			
<u>2"</u> If telescope see back. (size)			
(5) screen <u>15'</u> , <u>260'</u> (length) (depth to top)			
<u>2"</u> , <u>Stainless Steel</u> (size) (material)			
(6) pump <u>3-Air</u> <u>15</u> (HP) (yield gpm)			
<u>Electric</u> (type power)			
(7) electric log <u>no</u> (yes or no)			
(organization running log)			
(8) how well bottom plugged <u>2" Backwash</u> <u>Valve</u>			
<b>DRILLERS REMARKS:</b>			

JAN - 9 1970

MISS. BD. WATER COMMISSIONERS

If well telescopes please sketch and show depths.

GROUND LEVEL

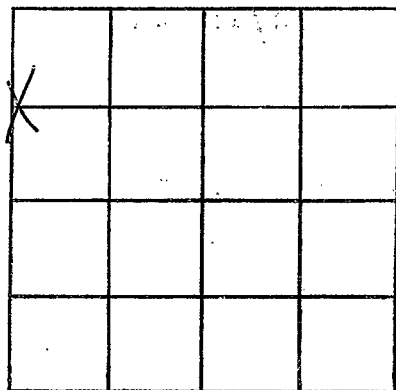

SECTION 17

Please indicate well location X.

ADDITIONAL INFORMATION

If more than one screen, show locations of each on sketch.