

MISSISSIPPI DEPARTMENT OF NATURAL RESOURCES

Bureau of Land and Water Resources

COUNTY WELL LOCATED ADAMS Scott		
WELL NUMBER C 2002	CODED	PERMIT NUMBER
NAME OF DRILLING FIRM Thomas Drilling		
DATE WELL COMPLETED 7-6-95		

P.O. Box 10631
Jackson, Mississippi 39209
WATER WELL DRILLERS LOG

NAME & MAILING ADDRESS OF LANDOWNER Kermit Reynolds		
759 Woodlawn Dr. N		
Forest MS 39074		
WELL LOCATION: SEC	TOWNSHIP	RANGE
29	8 S	8 W
DISTANCE	DIRECTION	NEAREST TOWN
3 Miles	N	Hillsboro
OTHER LANDMARK 2 1/2 miles E of LILIAN		
WELL PURPOSE: <input checked="" type="checkbox"/> Home Irrigation, <input type="checkbox"/> Municipal, <input type="checkbox"/> Industrial, <input type="checkbox"/> Fish Pond, etc.		

PUMP DATA		
PUMP TYPE (Circle One): <input checked="" type="checkbox"/> Submersible Turbine, Jet Flowing Well, Other (Describe) _____		
POWER TYPE (Circle One): <input checked="" type="checkbox"/> Electric, Tractor, Diesel, Gasoline, Butane, Other (Describe) _____		
Pump Capacity (GPM)	No. of Stages	Setting Depth
35	9	80 FT.
PUMP TEST		
Well yielded _____ GPM with		
a drawdown of 30 ft.		
after 1 hours of pumping		

WELL DATA		
Well Depth 115'	Casing Diameter (In.) 4"	Casing Length (Ft.) 105'
Type of Casing PVC	Hole Depth 115'	Depth to Static Water Level 9'
TYPE OF COMPLETION: (Circle One or More): <input checked="" type="checkbox"/> Gravel Packed, <input type="checkbox"/> Underreamed, <input type="checkbox"/> Telescoped, <input type="checkbox"/> Natural Development, <input type="checkbox"/> Open Hole, <input type="checkbox"/> Other		
Top of Lap Pipe or Reduction in Casing		
FEET IF TELESCOPED OR MORE THAN ONE SCREEN: USE BACK PAGE		

LOG DATA	
TYPE OF LOG RUN (Circle One): <input checked="" type="checkbox"/> No Log Run, Electric, Gamma Ray, Density, Sonic, Neutron, Other (Describe) _____	
Name of Organization Running Log	


SCREEN DATA		
Diameter - Inches 4	Length - Feet 10'	Slot Size - Inches .010
Screen Type PVC wrapped		Depth to Bottom - Feet 115'

GEOLOGIC DATA (Office Use Only)			
Surface Elev.	Geologic Unit	Unit Thickness	Depth to Top
Subs. SWL	Date	Analysis	Aquifer Test
Driller's Remarks			

DESCRIPTION OF FORMATIONS ENCOUNTERED	FROM	TO	FORMATIONS (Continued)	FROM	TO
Dirt	0	2	RECEIVED		
GRAY Pipe Clay	2	80			
Medium SAND	80	125			
			APR 22 1995		
			Dept. of Environmental Quality		
			Office of Land & Water Resources		
IF MORE SPACE IS NEEDED, USE BACK					

If well telescopes please
sketch and show depths.

GROUND LEVEL

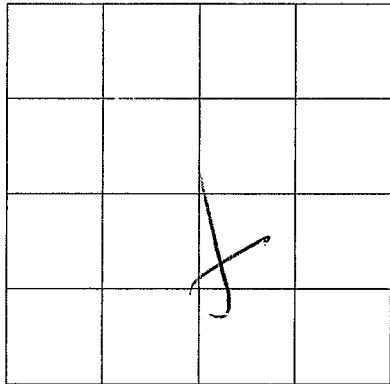

SECTION 29

Please indicate well location X.

ADDITIONAL INFORMATION

If more than one screen,
show location of each on sketch.