

P.S this is well no# 1 & 2,  
both alike,

CODED

MISSISSIPPI  
BOARD OF WATER COMMISSIONERS  
416 North State Street  
Jackson, Mississippi 39201

WATER WELL DRILLERS LOG

Scott Co

DI

4-10-63

April 10, 1963  
date well completed

Common Drilling  
firm name

county well located

LANDOWNER:

description of formations  
encountered

from

to

Sebastopol Water also

Clay

0 40

Sebastopol Miss  
(mailing address)

Sand Fin

40 60

Clay

60 68

WELL LOCATION:

Sand

68 149

sec. 1 T. 8 N R. 9 E  
S W

Rock with sand  
layers

149 148

FN Sebastopol Miss  
(distance) (direction) (nearest town)

Clay

148 220

WELL PURPOSE:

(home, irrigation, municipal, industrial)

Clay & Arch

220 250

WELL COMPLETION DATA:

Sand & Clay  
Layers

250 290

(1) diameter (inches) 6"

(2) total depth (feet) 290

(3) static water level (feet) 60 below  
top of ground.

(4) casing Steel 169  
(material) (depth)

4" If telescope see back.  
(size)

(5) screen 20 290  
(length) (depth to top)

14" Stainless Steel  
(size) (material)

(6) pump 5 60  
(HP) (yield gpm)

Electric  
(type power)

(7) electric log X  
(yes or no)

Miss State  
(organization running log)

(8) how well bottom plugged Backwash

DRILLERS REMARKS:

no. 241

CODED

CODED

APR 21 1969

MISS. BD. OF  
WATER COMM.


(X)

If well telescopes please sketch and show depths.

D1

GROUND LEVEL

Connected to  
20 ft below  
Surface.

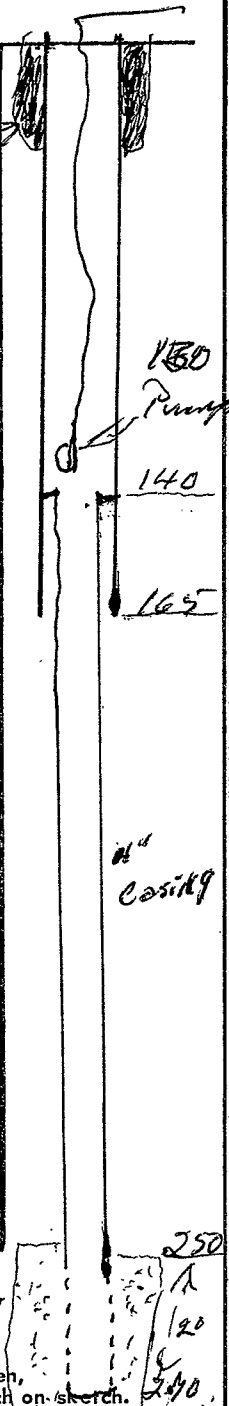

130  
Pump

140

165


6" casing

250

6" 11 Pipe →

120  
240

If more than one screen, show locations of each on sketch.

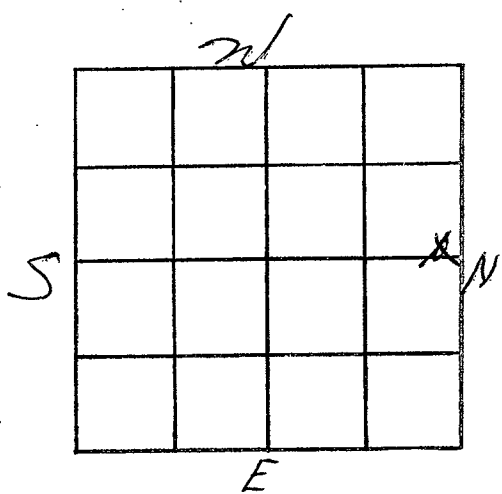

SECTION 1

Please indicate well location X.

ADDITIONAL INFORMATION

Blank lined area for additional information.