

SCOTT

MISSISSIPPI BOARD OF WATER COMMISSIONERS

5

D 11

3-15-62

WATER WELL DRILLERS LOG

3

Date: 3-15, 1962, Driller: Marshall Raymond County Scott

(Name)

(1) Owner of Land: J.H. Jones  
 (Name)  
Jandatta #1 Miss.  
 (Address)

(2) Location: 1/4, 1/4, Sec. 30 T8 R9  
1 1/2 miles West of Salatoga  
 (distance) (direction) (Nearest Town)

(3) Topography: X  
 (Hilly) (Flat) (Level)

(4) Purpose of Well: Domestic  
 (Domestic Irrigation  
 Municipal, Industrial, Other)

Description & Color of Materials Sand, Clay, Red Clay, Shell, etc.	Thick- ness Feet	Depth Feet
0-20 Grey. 20 to		
290 Water sand		
gradually getting		
coarser at about		
150 Feet		
290 Red about 6 inches		
knobby part		
Grey Shell.		
Shell ends 150 feet		
end 340 Fossiliferous		
red & red & shell		
Layer of yellow sand		
30 feet at 390		
a fragment of		
Coquina		
Green sand. To 394.		
Was not to bottom		
When drilling was		
stopped.		
Iron 35 <del>to</del> RMP		
P.H. 3.6		
Hardness 54 RMP		
Draw Down 30 Feet		
At 1510		

Information upon completion of well:

(1) Diameter 2 inches.

(2) Total Depth 399 feet.

(3) Water Level 35 feet below top of ground.

(4) Cased to 294, Size 2"


(5) Screen: Size 3/16", Length \_\_\_\_\_

(6) Were any formations sealed against pollution?  
 \_\_\_\_\_ yes, X no.

If YES depth of formation \_\_\_\_\_

Why \_\_\_\_\_

Drillers Remarks: Well was open  
to form. Minor formation

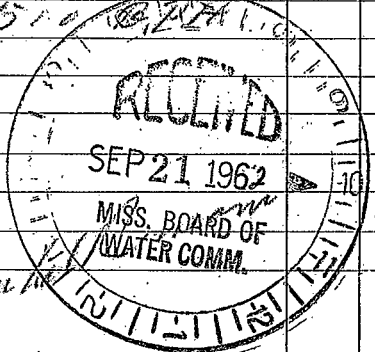

(Use Back Side)

Well No.

