

MISSISSIPPI BOARD OF WATER COMMISSIONERS

SCOTT

WATER WELL DRILLERS LOG

DIA T
7-19-65

Date: July 19, 1965, Driller: McDONALD + HILL County SAVANNAH
(Name)

(1) Owner of Land: DAVID CHISLORN
(Name)
Rt #5, DeKalb, Miss
(Address)

(2) Location: 1/4, 1/4, Sec. 9 T. 7 R. 15
1 miles S.E. of DAMASCUS
(distance) (direction) (Nearest Town)

(3) Topography: HILLY
(Hilly) (Flat) (Level)

(4) Purpose of Well: DOMESTIC
(Domestic Irrigation
Municipal, Industrial, Other)

Description & Color of Materials Sand, Clay, Red Clay, Shell, etc.	Thick- ness Feet	Depth Feet
CLAY	0	10
RED SAND	10	20
YELLOW CLAY	20	25
H. Shale	25	105
10' Sand M Sand	105	135

Information upon completion of well:

(1) Diameter 2 inches.


(2) Total Depth 135 feet.

(3) Water Level 74 feet below top of ground.

(4) Cased to 135, Size 2

(5) Screen: Size 2, Length 5 ft.

(6) Were any formations sealed against pollution?
no.

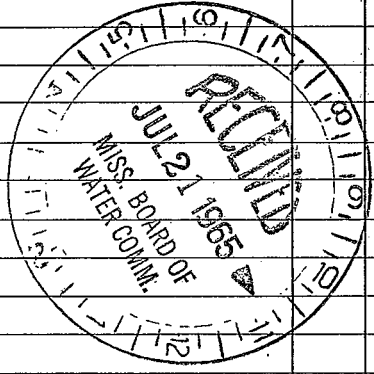

If YES depth of formation _____

Why _____

Drillers Remarks: _____

(Use Back Side)

Well No.

