

SCOTT MISSISSIPPI BOARD OF WATER COMMISSIONERS

5 D17 T
7-20-62

WATER WELL DRILLERS LOG

8 (13)

Date: 7-20, 1962, Driller: Wanda Korman County: Scott

(Name)

(1) Owner of Land: A. J. Mansel
(Name)
Wanda Korman
(Address)

(2) Location: 1/4, 1/4, Sec. 31 T. 8 R. 9
8 miles W of Scott
(distance) (direction) (Nearest Town)

(3) Topography: Level
(Hilly) (Flat) (Level)

(4) Purpose of Well: Domestic
(Domestic Irrigation, Municipal, Industrial, Other)

Description & Color of Materials Sand, Clay, Red Clay, Shell, etc.	Thick- ness Feet	Depth Feet
0-20 Sand		
20-85- Red Sand		
85-120 Rock		
120-175 Sand & Shell		
175-185 T. 250		
210-280 Chalk		
280-415 Sand White		
415-520		
520-545 Rock + Shell		
545-585 Manganese		
585-615		
Green Chalk		

Information upon completion of well:

(1) Diameter 2 inches.

(2) Total Depth 615 feet.

(3) Water Level 130 feet below top of ground.

(4) Cased to 1418, Size 2


(5) Screen: Size None, Length _____

(6) Were any formations sealed against pollution?
_____ yes, _____ no.

If YES depth of formation _____

Why _____

Drillers' Remarks: _____

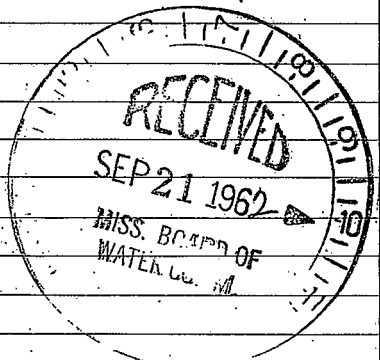

(Use Back Side)

Well No.

