

CODED

MISSISSIPPI  
BOARD OF WATER COMMISSIONERS  
416 North State Street  
Jackson, Mississippi 39201

WATER WELL DRILLERS LOG

SCOTT

SCOTT  
D 20  
11-15-69

11-15 1969 Comac Drilling Service Scott  
date well completed firm name county well located

LANDOWNER: Allis Pierce

Cornehotta R#1 Minn  
(mailing address)

WELL LOCATION:  
sec 12 T 8 N R 9 E  
2 miles S of Sebastopol  
(distance) (direction) (nearest town)

WELL PURPOSE: FERTIGATION  
(home, irrigation, municipal, industrial)

WELL COMPLETION DATA:

- (1) diameter (inches) 2"
- (2) total depth (feet) 179
- (3) static water level (feet) 4 FT ABOVE SURFACE above top of ground.
- (4) casing P.V.C. 80 (material), (depth)
- if telescope see back. (size)
- (5) screen None (length) (depth to top)  
None (size) (material)
- (6) pump None 5 (HP) (yield gpm)  
(type power)
- (7) electric log No (yes or no)  
(organization running log)

description of formations encountered	from	to
<u>0-124</u>	<u>0</u>	<u>12</u>
<u>Sand</u>	<u>12</u>	<u>40</u>
<u>Sand</u>	<u>40</u>	<u>130</u>
<u>Sand + shell</u>	<u>130</u>	<u>179</u>


FEB 16 1970

DRILLERS REMARKS: Open Bottom And Flow

MISS. RD. OR  
WATER BOARD

If well telescopes please sketch and show depths.

GROUND LEVEL

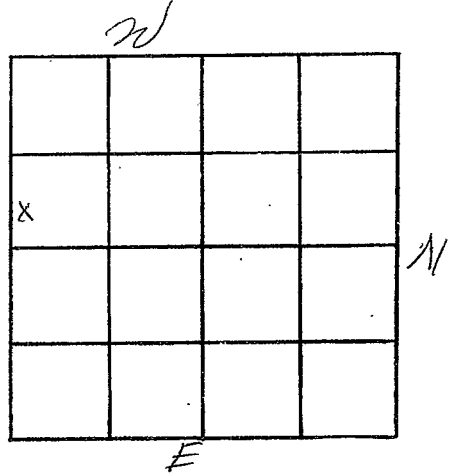

SECTION 12

Please indicate well location X.

ADDITIONAL INFORMATION

If more than one screen,  
show locations of each on sketch.