

SCOTT
D21
4-11-70

MISSISSIPPI
BOARD OF WATER COMMISSIONERS
416 North State Street
Jackson, Mississippi 39201

CODED

WATER WELL DRILLERS LOG

4-11-1970 date well completed
Common Drilling Scott firm name
county well located

LANDOWNER: J.W. Tull
Combatta R#1
Miss (mailing address)

WELL LOCATION:
sec. 13 T. 8 N R. 9 E
2 miles S of Sebastopol
(distance) (direction) (nearest town)

WELL PURPOSE: Home
(home, irrigation, municipal, industrial)

WELL COMPLETION DATA:

- (1) diameter (inches) 2"
- (2) total depth (feet) 320
- (3) static water level (feet) 80 below top of ground.
- (4) casing 5" 293' (material) (depth)
- (size) if telescope see back.
- (5) screen (length) (depth to top)
- (size) (material)
- (6) pump 1 300 GPH (HP) (yield gph)
- Electric (type power)
- (7) electric log None (yes or no)
- (organization running log)
- (8) how well bottom plugged

description of formations encountered	from	to
Clay	0	30
Sand	30	80
Clay	80	114
Sand	114	190
Rock + Black Sand	190	211
Clay	211	298
Shale + Rock	298	302
ALABAMA SAND	302	320

CODED


AUG 5 1970

DRILLERS REMARKS:
Open Bottom

MISS. BD. OF
WATER COMM.

If well telescopes please sketch and show depths.

GROUND LEVEL

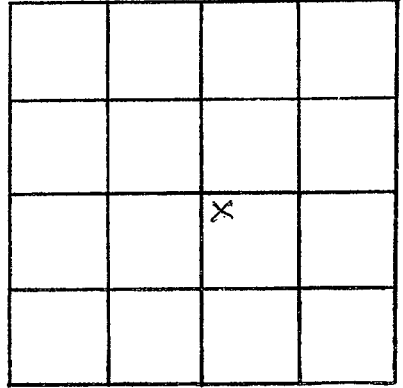

SECTION 13

Please indicate well location X.

ADDITIONAL INFORMATION

If more than one screen,
show locations of each on sketch.