

MISSISSIPPI
 BOARD OF WATER COMMISSIONERS
 416 North State Street
 Jackson, Mississippi 39201

CODED

WATER WELL DRILLERS LOG

SCOTT
 D22
 4-23-70

4 23 19 70 *Leonas Drilling Scott*
 date well completed firm name county well located

LANDOWNER: *Jim Barrett*
Barrett #1
Barrett
 (mailing address)

description of formations encountered	from	to
<i>Clay</i>	0	30
<i>Clay & sand</i>	30	98
<i>Clay</i>	98	140
<i>Sand</i>	140	210

WELL LOCATION:
 sec 23 T 8 N R 9 E
3 miles SW of Sebastopol
 (distance) (direction) (nearest town)

WELL PURPOSE: FOUN
 (home, irrigation, municipal, industrial)

WELL COMPLETION DATA:

- (1) diameter (inches) 4"
- (2) total depth (feet) 210
- (3) static water level (feet) 80 below above top of ground.
- (4) casing PVC (material), (depth) _____
 _____ if telescope see back.
 (size)
- (5) screen 20, 190 (length) (depth to top)
4", PVC (size) (material)
- (6) pump 1 1/2, 15 (HP) (yield gpm)
Electric (type power)
- (7) electric log None (yes or no)
 _____ (organization running log)
- (8) how well bottom plugged _____

CODED


AUG 5 1970

MISS. BD. OF
 WATER COMMISSIONERS

DRILLERS REMARKS:

If well telescopes please sketch and show depths.

GROUND LEVEL

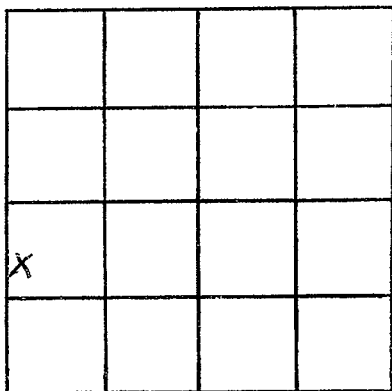

SECTION 23

Please indicate well location X.

ADDITIONAL INFORMATION

If more than one screen,
show locations of each on sketch.