

SCOTT
D24
9-26-70

MISSISSIPPI
BOARD OF WATER COMMISSIONERS
416 North State Street
Jackson, Mississippi 39201

CODED

WATER WELL DRILLERS LOG

9-26 1970 R.R. Nicholson Scott
date well completed firm name county well located

LANDOWNER: Dwight Benson
Conehatta, MS
(mailing address)

| Description of formations encountered | from | to |
|---------------------------------------|------|------|
| Clay & chalk | 0 | 2.0 |
| Chalk & sand | 2.0 | 3.5 |
| Blue clay | 3.5 | 9.8 |
| Shell rock | 9.8 | 10.3 |
| Water clay | 10.3 | 16.5 |
| Water sand | 16.5 | 18.5 |

WELL LOCATION:
 sec 17 T 8 N ? R 10 E
12 miles north of Forest
 (distance) (direction) (nearest town)

WELL PURPOSE: private
 (home, irrigation, municipal, industrial)

- WELL COMPLETION DATA:
- (1) diameter (inches) 4"
 - (2) total depth (feet) 185
 - (3) static water level (feet) _____ below/above top of ground.
 - (4) casing pyrex 175
 (material) (depth)
 (size) if telescope see back.
 - (5) screen 10 185
 (length) (depth to top)
2" Johnson
 (size) (material)
 - (6) pump 1/2 24
 (HP) (yield gpm)
R.E.P.
 (type power)
 - (7) electric log _____
 (yes or no)
 - (organization running log) _____
 - (8) how well bottom plugged _____

CODED


DEC 15 1970

MISSISSIPPI
BOARD OF
WATER COMMISSIONERS

DRILLERS REMARKS:

If well telescopes please sketch and show depths.

GROUND LEVEL

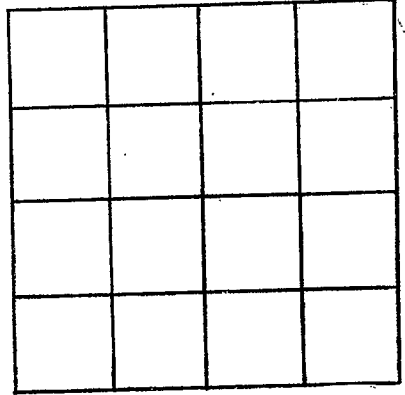

SECTION _____

Please indicate well location X.

ADDITIONAL INFORMATION

If more than one screen, show locations of each on sketch.