

SCOTT  
 D25  
 9-30-70

MISSISSIPPI  
 BOARD OF WATER COMMISSIONERS  
 416 North State Street  
 Jackson, Mississippi 39201

**CODED**

WATER WELL DRILLERS LOG

9-30 1970 R. D. Nicholson Scott  
 date well completed firm name county well located

LANDOWNER: Ernest Salomon  
Conehatta, ms  
 (mailing address)

WELL LOCATION:  
 sec 28 T-8 N 9 W R-9 E  
 (distance) miles of (direction) (nearest town)

WELL PURPOSE: Home  
 (home, irrigation, municipal, industrial)

- WELL COMPLETION DATA:
- (1) diameter (inches) 4"
  - (2) total depth (feet) 256
  - (3) static water level (feet) 114 below above top of ground.
  - (4) casing Pipe, 24 (material), (depth)
  - (size) if telescope see back.
  - (5) screen 2", 256 (length), (depth to top)
  - 2", Johnson S.S. (size), (material)
  - (6) pump 1/2, 26 (HP), (yield gpm)
  - R.F.P. (type power)
  - (7) electric log (yes or no)
  - (organization running log)
  - (8) how well bottom plugged

description of formations encountered	from	to
<u>Clay &amp; Chalk Shell</u>	<u>0</u>	<u>21</u>
<u>rock</u>	<u>21</u>	<u>23</u>
<u>Shell</u>	<u>25</u>	<u>33</u>
<u>Blue clay</u>	<u>33</u>	<u>74</u>
<u>metal dirt + sand</u>	<u>74</u>	<u>190</u>
<u>Water sand</u>	<u>190</u>	<u>228</u>
		<u>256</u>

**CODED**


DEC 15 1970

MISS. BD. OF  
 WATER COMM.

DRILLERS REMARKS:

If well telescopes please sketch and show depths.

GROUND LEVEL

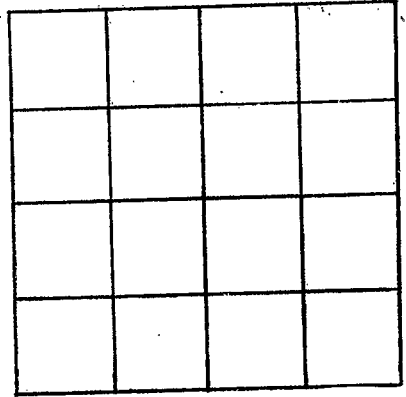

SECTION \_\_\_\_\_

Please indicate well location X.

ADDITIONAL INFORMATION

If more than one screen, show locations of each on sketch.