

SCOTT  
D26  
5-11-71

MISSISSIPPI  
BOARD OF WATER COMMISSIONERS  
416 North State Street  
Jackson, Mississippi 39201

**CODED.**

WATER WELL DRILLERS LOG

5-11-71  
date well completed

19

firm name

county well located

LANDOWNER: C.D. Thrash  
Donhalla Rth 1  
Minn  
(mailing address)

description of formations encountered

from

to

Clay

0 50

Sand

80 100

WELL LOCATION:

sec. 5 T 8 N R 9 E  
4 miles N of Sebastopol  
(distance) (direction) (nearest town)

WELL PURPOSE: Home  
(home, irrigation, municipal, industrial)

WELL COMPLETION DATA:

- (1) diameter (inches) 2 1/2
- (2) total depth (feet) 110
- (3) static water level (feet) 60 below above top of ground.
- (4) casing 5" steel (material) (depth) (size) If telescope see back.
- (5) screen 5' 105" (length) (depth to top) 2 1/2" 5/8" (size) (material)
- (6) pump 1/2 (HP) 5 (yield gpm) Electric (type power)
- (7) electric log No (yes or no)

**CODED.**

(organization running log)

APR 11 1972


(8) how well bottom plugged Good Well

MISS. BU. JI  
MEMBER COM.

DRILLERS REMARKS:

If well telescopes please sketch and show depths.

GROUND LEVEL

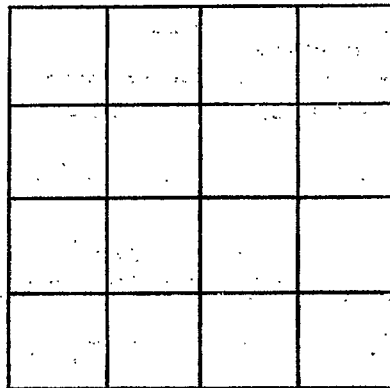

SECTION \_\_\_\_\_

Please indicate well location X.

ADDITIONAL INFORMATION

If more than one screen,  
show locations of each on sketch.